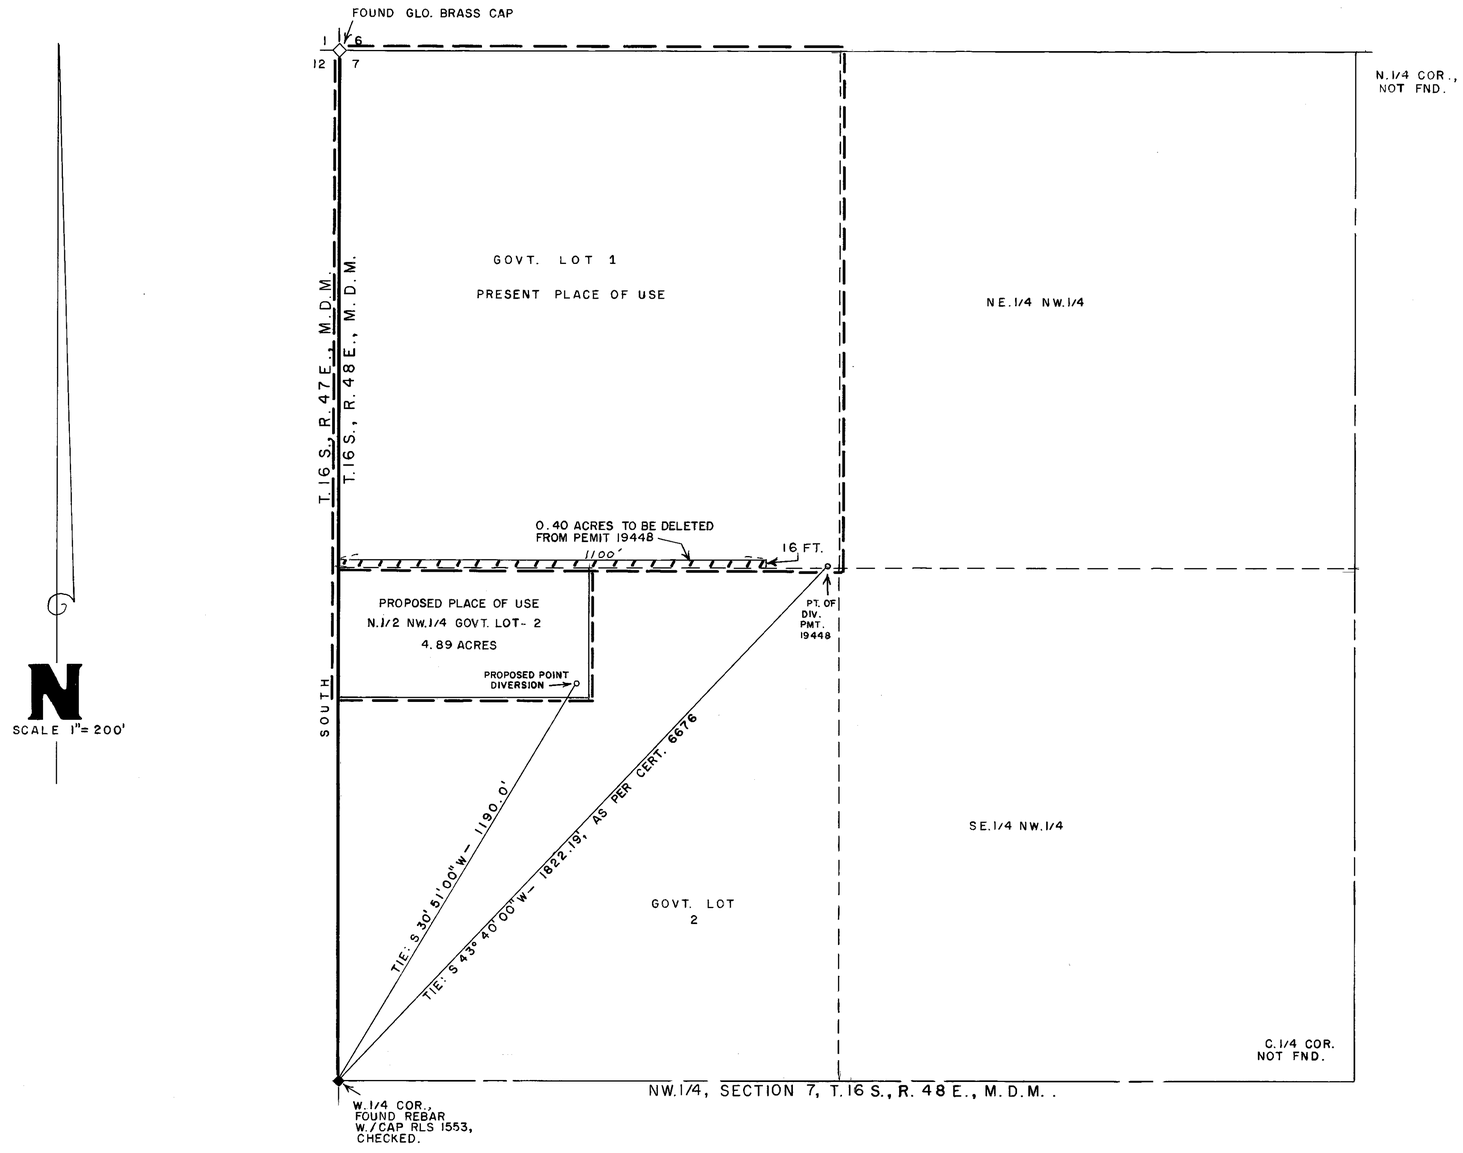

N

SCALE 1"= 200'

BASIS OF BEARINGS:

SOUTH, BEING THE WEST LINE OF SECTION 7, T.16 S., R.48 E., M.D.M., AS SHOWN ON THE GLO. PLAT MAP DATED 1922.

LEGEND:

— — — BOUNDARY OF PRESENT & PROPOSED PLACES OF USE.

o PRESENT & PROPOSED POINTS OF DIVERSION.

INDICATES AREA TO BE DELETED FROM PERMIT 19448.

STATE OF **NEVADA**
COUNTY OF **NYE**

I, LISLE LOWE, BEING FIRST DULY SWORN, DEPOSE AND SAY THAT THIS MAP CONSISTING OF ONE SHEET, HAS BEEN CORRECTLY DRAWN TO THE DESIGNATED SCALE FROM FIELD NOTES OF A SURVEY MADE BY ME OR UNDER MY SUPERVISION AND DIRECTION ON **JUNE 13, 1999**, THAT IT TRULY AND CORRECTLY REPRESENTS THE PROPOSED LOCATION AND EXTENT OF THE WORKS USED TO DIVERT WATER FROM AN UNDERGROUND SOURCE IN **NYE COUNTY, NV, BY CHARLES WILLIAM BARRACKMAN**, THAT THE PROPOSED POINT OF DIVERSION, THE MANNER OF USE AND LOCATION AND NAMES OF ALL OTHER WORKS OR STREAMS WHICH ARE CROSSED BY OR CONNECTED WITH THE SAID WORKS ARE FULLY AND CORRECTLY DESIGNATED THEREON.

Lisle Lowe
STATE WATER RIGHT SURVEYOR #856, P.L.S. #8423

PROFESSIONAL LAND SURVEYOR — STATE OF NEVADA — LISLE LOWE — No. 8423
6/22/99

SUBSCRIBED AND SWORN TO BEFORE ME THIS 22 DAY OF June, 1999

Andrea Lynn
NOTARY PUBLIC IN AND FOR SAID COUNTY AND STATE

NOTARY PUBLIC STATE OF NEVADA — County of Nye — ANDREA LYNN — No. 96-0311-1 — My Appointment Expires Jan. 19, 2000

MY COMMISSION EXPIRES ON: Jan. 19, 2000

65237 ~~CERTIFICATE NO.~~ 17176 ~~ISSUED~~ 3-8-09

200' 100' 0' 200' 400'
SCALE 1"= 200'

STATE ENGINEER'S USE

WKM, 7-8-99 Existing point of diversion lies in Govt. Lot 2. See letter of 12-8-67 in file 19448.

65237

FILED
JUL 08 1999
STATE ENGINEER'S OFFICE

MAP TO ACCOMPANY AN APPLICATION TO CHANGE THE POINT OF DIVERSION AND MANNER OF USE, AND PLACE OF USE FOR A PORTION OF PERMIT 19448, CERTIFICATE 6676.

FOR: COMMERCIAL PURPOSES.

BY: CHARLES WILLIAM BARRACKMAN.

FROM: AN UNDERGROUND SOURCE IN NYE COUNTY, NV.

65237