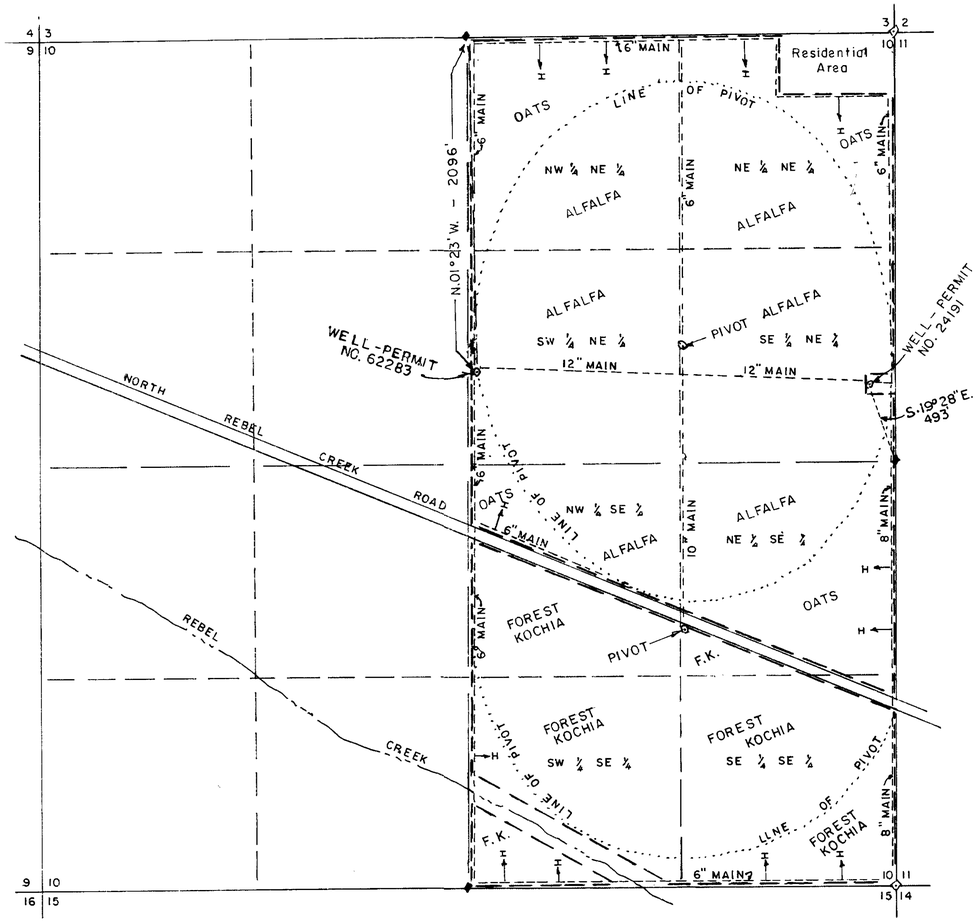

N

M.D.B.&M.

NOTE:

→H denotes hand water lines and direction of flow from various ties to main lines to irrigate the areas outside of the pivot areas.

STATE OF NEVADA
COUNTY OF WASHOE SS:

I, Ernest E. Muller, Sr., being first duly sworn, depose and say that this map, consisting of one sheet, has been correctly drawn to the designated scale from field notes of a survey made by me on the 3rd. day of November, 2001; that it truly and correctly represents the location and extent of the works used to divert water from an underground source in Humboldt County by Robert R. and Wendy J. Dexter for Irrigation and Domestic Purposes under Application No. 62283. That the point of diversion, the size and location of the distribution pipes, and the location of the existing well under Application No. 24191, Certificate No. 6874 which is used when necessary to supplement the waters from Permit No. 62283 and which is connected to the same pipe system, and other works works or streams which are crossed by said works are fully and correctly designated thereon.

State Water Right Surveyor No. 702
HWYE No. 827

Subscribed and sworn to before me on this 13th. day of November, 2001.

Notary Public in and for the County of Washoe, State of Nevada

Bearing source is a government plat dated February 27, 1957 showing the East line of Section 10 as N.00°02' W.

Found corners are standard government brass caps.

SCALE: 1 INCH = 500 FEET

500 0 660 1320 2640

Township	Range	Section	Subvision	Cultivated Acreage	Description of Culture	Date of First Culture
43 N.	37 E.	10	NE ¼ NE ¼ NE ¼ NE ¼	20.1 12.6	Alfalfa Oats	
			NW ¼ NE ¼ NW ¼ NE ¼	19.9 18.3	Alfalfa Oats	
			SW ¼ NE ¼ SW ¼ NE ¼	37.8 2.0	Alfalfa Oats	
			SE ¼ NE ¼ SE ¼ NE ¼	36.9 1.7	Alfalfa Oats	
			NE ¼ SE ¼ NE ¼ SE ¼ NE ¼ SE ¼	18.7 16.7 2.8	Alfalfa Oats Forest Kochia	
			NW ¼ SE ¼ NW ¼ SE ¼ NW ¼ SE ¼	17.4 15.0 4.5	Forest Kochia Alfalfa Oats	
			SW ¼ SE ¼	33.3	Forest Kochia	
			SE ¼ SE ¼ SE ¼ SE ¼	36.6 0.3	Forest Kochia Oats	
			Total	294.6	All Crops	

FOR STATE ENGINEER'S USE

68633 & 68634

FILED
APR 5 02

MAP TO ACCOMPANY APPLICATIONS
CHANGE PLACE OF USE OF APPLICATION
NO. 24191, CERTIFICATE NO. 6874
AND OF APPLICATION NO. 62283
AND MAP
TO ACCOMPANY APPLICATION
FOR PROOF OF BENEFICIAL USE
OF APPLICATIONS NO. 68633 AND 68634
FOR
ROBERT R. & WENDY J. DEXTER
For IRRIGATION and DOMESTIC PURPOSES
FROM UNDERGROUND SOURCES
IN HUMBOLDT COUNTY, NEVADA

E. E. M. SR. 750 WEST PUEBLO ST., RENO, NV., 89509 | 01.11.02

82385 82384 80183 80182 68634 68633