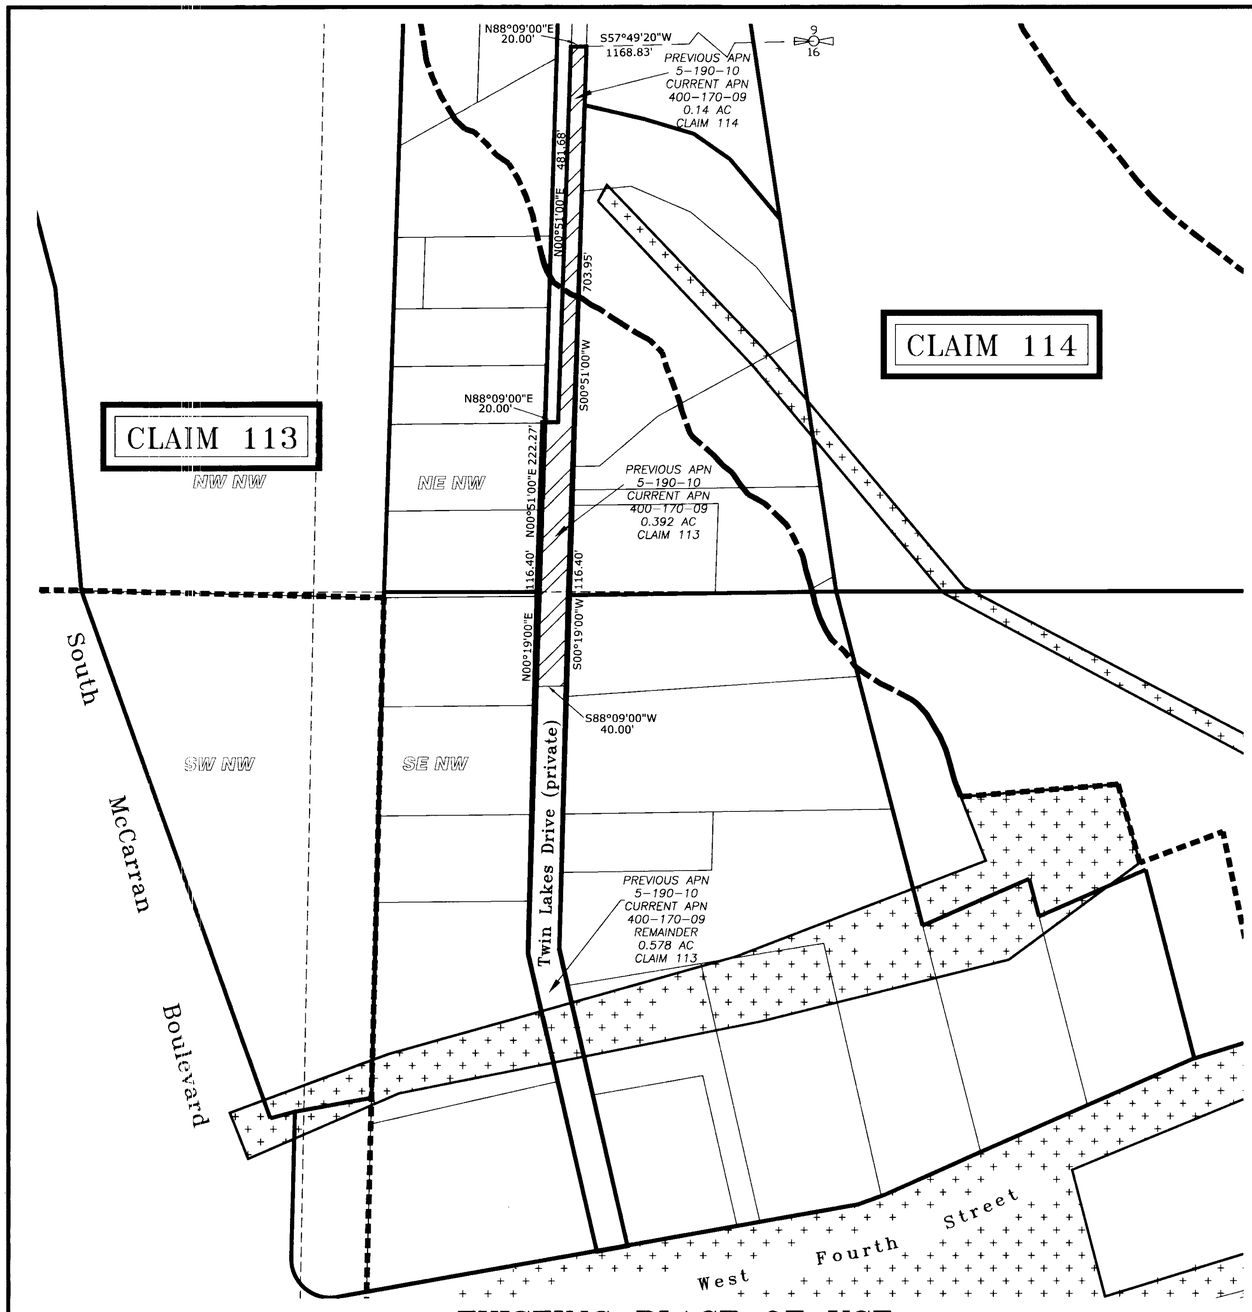

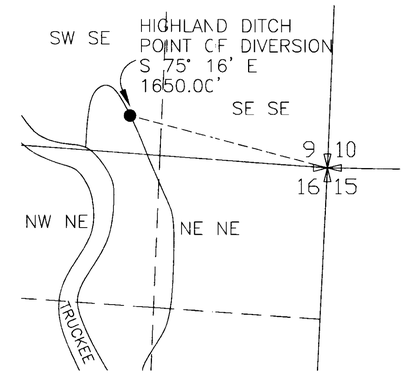

EXISTING POINT OF DIVERSION
HIGHLAND DITCH
T. 19 N., R. 18 E., M.D.M.

BASIS OF BEARINGS

TIE AND BEARING DESCRIPTION TO EXISTING POINT OF DIVERSION FROM THE TRUCKEE RIVER DECREE AND THE FEDERAL WATER MASTER.

LEGEND

- lot/parcel line
- block boundary
- decree claim boundary
- section / 1/4 section / 1/4 1/4 section } Public Land Survey System (PLSS) lines
- dry area not containing decreed water rights

EXISTING PLACE OF USE
TRUCKEE RIVER CLAIMS 113 AND 114, TR-011

PORTIONS OF NE $\frac{1}{4}$ NW $\frac{1}{4}$ AND SE $\frac{1}{4}$ NW $\frac{1}{4}$, SEC 16, T. 19 N., R. 19 E., M.D.M.

PORTION OF CLAIMS 113 AND 114 TO BE TRANSFERRED TO WASHOE COUNTY - CLAIM 113 - 0.392 AC = 1.47 AF
CLAIM 114 - 0.14 AC = 0.53 AF = ~~TOTAL 0.532 AC = 2.00 AF~~ GCA

100' 50' 0 100'
Scale Feet
1" = 100'

State of Nevada
County of Washoe ss.

I, Glen C. Armstrong, being first duly sworn, depose and say that this map consisting of one sheet, has been correctly drawn to the designated scale from information on file in the Official Records of Washoe County, Nevada, maps prepared by the Washoe County Assessor, and information reproduced electronically from the maps of the Truckee River Adjudicated Suit – United States of America vs. Orr Water Ditch Company, et.al., that is truly and correctly represents the extent and location of the Place of Use of water heretofore appropriated under a portion of Claim numbers 113 ~~and 114,~~ GCA by Washoe County, for Municipal and Domestic purposes: that the Place of Use, the location and name of all other works, and the boundary of all lands shown by 40 acre subdivisions are fully designated hereon.

PROFESSIONAL LAND SURVEYOR STATE OF NEVADA
GLEN C. ARMSTRONG
Exp: 12-31-06
No. 16451
8-9-06

Glen C. Armstrong
Professional Land Surveyor No. 16451
State Water Rights Surveyor No. 1140

Subscribed and sworn before me on this 9th day of August, 2006.

Andrea Hall
Notary Public

ANDREA HALL
Notary Public - State of Nevada
Appointment Recorded in Washoe County
No: 05-98178-2 - Expires July 7, 2009

POINT OF DIVERSION AFTER TRANSFER

Existing Truckee Meadows Water Authority Points of Diversion as described in Application No. 71606 and shown on the supporting map accompanying said application on file with the State Engineer's Office.

PLACE OF USE AFTER TRANSFER

All that certain area designated in Application No. 71606, and shown on the map supporting said application on file in the State Engineers Office, Division of Water Resources, State of Nevada.

ELECTRONIC FILE LOCATION: J:\131\TMWR\dwg\WRtrnsf-Clm113-114_6-06.dwg

Project No:	131-01-05
Date:	2006/06/19
Drawn by:	AH
Designed by:	GCA
Checked by:	
Horiz. scale:	1" = 100'
Vertical scale:	N/A
Projection:	NV SPW US FEET
Horiz. datum:	NAD83
Vertical datum:	N/A

US GEOMATICS
P.O. Box 3299
Reno, NV 89505
p. 775.560.8516
f. 775.747.6514
www.usgeomatics.com

STATE ENGINEER'S USE

8/10/06 REL Claim 114 water illustrated on this map will be transferred by later application.

74544
FILED
AUG 1 2006
STATE ENGINEER'S

2006 AUG 10 PM 12:08

GCA

MAP TO ACCOMPANY AN APPLICATION TO CHANGE THE POINT OF DIVERSION, PLACE AND MANNER OF USE OF A PORTION OF CLAIMS 113 ~~AND 114~~ OF THE TRUCKEE RIVER DECREE FOR MUNICIPAL AND DOMESTIC PURPOSES BY WASHOE COUNTY FROM WATERS OF THE TRUCKEE RIVER WITHIN WASHOE COUNTY, NEVADA

74544