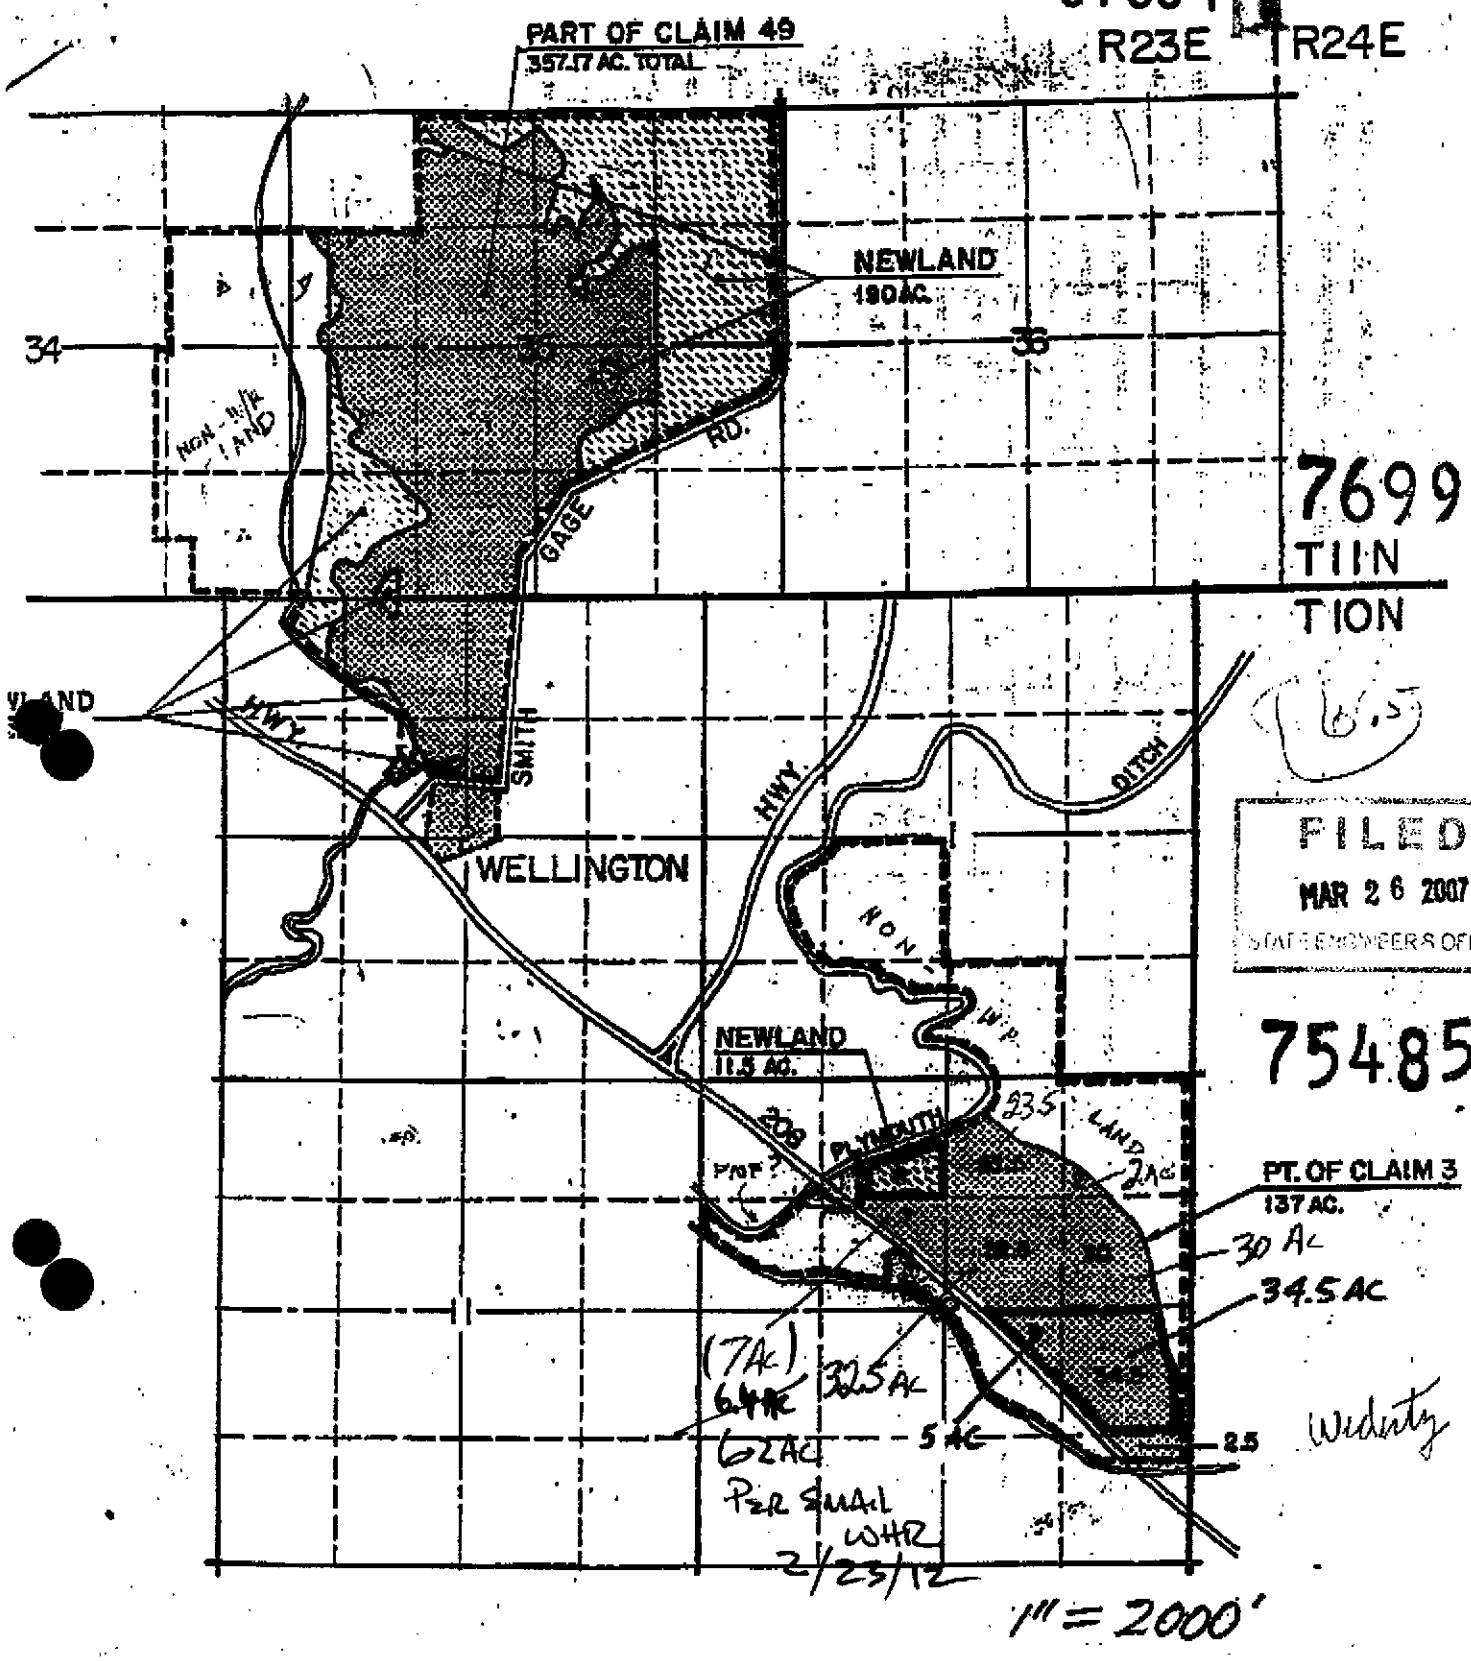

75485T

56200T

PRESENT WATER RIGHTS MAP—LOCATION № 4

OWNERSHIP: F. M. FULSTONE INC.

DATE DRAWN: FEB. 12, 1986

PROPOSED PLACE OF USE

MAP TO ACCOMPANY APPLICATION FOR A TEMPORARY WATER RIGHT

~~FILED~~ ~~APR 1 0 1991~~ STATE ENGINEER'S OFFICE

SHEET 1 OF 2

~~56200T~~