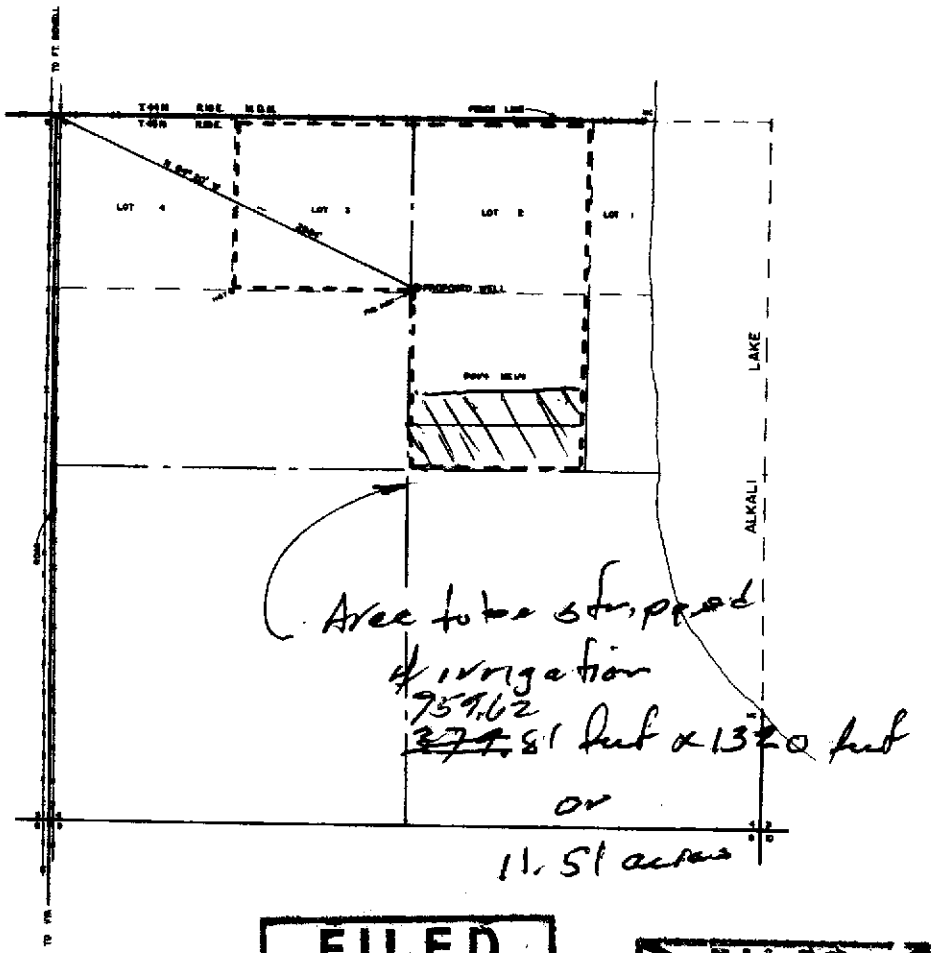

BASIS OF BEARINGS: B.L.M. PLAT OF 1979, I.E., NORTH LINE OF SECTION 4 - EAST.

NOTE: EVIDENCE FOR THE LOCATION OF THE NE CORNER OF SECTION 4 WAS BASED ON OWNER TESTIMONY, LOCATION OF FENCE LINES & ROADS, FOUND H.B.T'S AT PROPERTY CORNERS AND THE U.S.G.S. QUAD MAP "ALKALI LAKE, NEV." 7.5' QUAD.

SURVEYOR'S CERTIFICATE

STATE OF NEVADA
COUNTY OF WASHOE ss

I, GERALD STANTON, BEING FIRST DULY SWORN, DEPOSE AND SAY THAT THIS MAP, CONSISTING OF ONE SHEET, HAS BEEN CORRECTLY DRAWN TO THE DESIGNATED SCALE FROM FIELD NOTES OF A SURVEY MADE BY ME ON DECEMBER 7, 1979; THAT IT TRULY AND CORRECTLY REPRESENTS THE PROPOSED EXTENT AND LOCATION OF THE PLACE OF USE OF WATER, FROM AN UNDERGROUND SOURCE, FOR IRRIGATION AND DOMESTIC PURPOSES; THAT THE POINTS OF DIVERSION, PROPOSED PLACE OF USE, THE BOUNDARY OF ALL LANDS, AND THE LOCATION AND NAMES OF ALL OTHER WORKS OR STREAMS WHICH ARE CROSSED BY CONNECTED WITH SAID WORKS, SHOWING BY 40-ACRE SUBDIVISIONS THE AREAS PROPOSED TO BE SERVED, ARE FULLY AND CORRECTLY DESIGNATED THEREON.

GERALD R. STANTON
STATE WATER RIGHT SURVEYOR NO. 6[illegible]

NOTARY'S CERTIFICATE

SUBSCRIBED AND SWORN TO BEFORE ME THIS 19th DAY OF December, 1979.

Barbara J. Smith
NOTARY PUBLIC

SCALE 1" = 400'

MAP
TO ACCOMPANY APPLICATION TO
APPROPRIATE WATER
FOR
IRRIGATION AND DOMESTIC PURPOSES
BY
PAUL V. THOMPSON
FROM
AN UNDERGROUND SOURCE
IN WASHOE COUNTY, NEVADA

FILED
MAR 2 4 2011
STATE ENGINEER'S OFFICE

~~FILED~~
~~MAR 0 9 2010~~
~~STATE ENGINEER'S OFFICE~~

FILED

~~38437~~

80701T ~~80701T~~ ~~79675T~~