Section	Sub-division	Town-ship	Range	Cultivated Acreage	Kind of culture	Date of first cultivation
13	SE¼ SE¼	42 N.	28 E.	5.45	Alfalfa	Harvest
"	NE¼ SE¼	"	"	6.44	"	Harvest
"	" "	"	"	0.30	Garden	Harvest
"	SE¼ NE¼	"	1.00	~~4.85~~	Alfalfa	Harvest
"	" "	"	0.50	~~0.60~~	Garden	Harvest
"	NE¼ NE¼	"	"	1.50	"	Harvest
"	" "	"	"	7.81	Alfalfa	Harvest

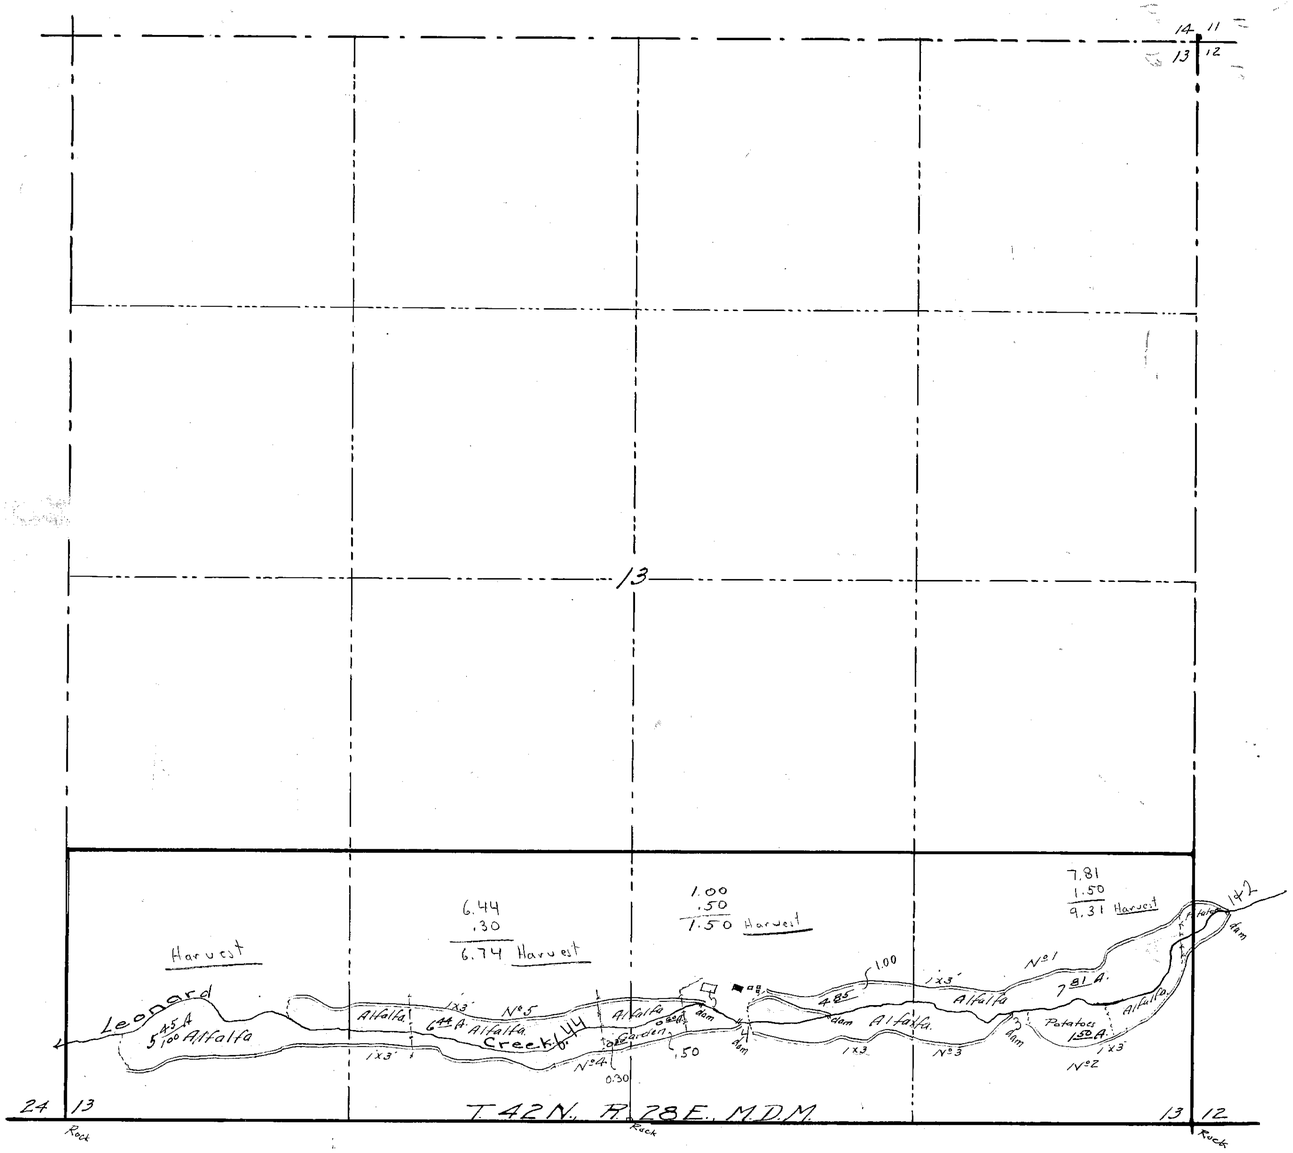

State of Nevada }
County of Humboldt } ss

I, H. H. Sheldon, being first duly sworn, depose and say that the above map is a true and accurate plat of a survey made by me, completed on the 15th day of October, 1919.

That the map and survey were made at the instance of Montaro & Co., owners of said lands, and that it truly represents the irrigated lands of said Montaro & Co.

H. H. Sheldon, C.E.
Surveyor.

Subscribed and sworn to before me this day of January, 1920

L. G. Wilson
Notary Public in and for Humboldt Co., Nevada.

FILED
Feb. 4, 1920
STATE ENGINEER'S OFFICE

PROOF NO. 01683 } CERTIFICATE NO. 443 ISSUED 11-20-72
AND AMENDED PROOF NO. 01683

MAP
OF
IRRIGATED LANDS
OF
MONTARO & CO.
FROM
LEONARD CREEK
HUMBOLDT CO., NEVADA
JAN. 1920 SCALE 1"=400'

01683