Sec.	Sub.	T.	R.	Acreage	Culture	Date.
19		30N	59E.	29.0	Meadow.	
				15.0	Pasture	
				3.7	Garden	
			Total	47.7		

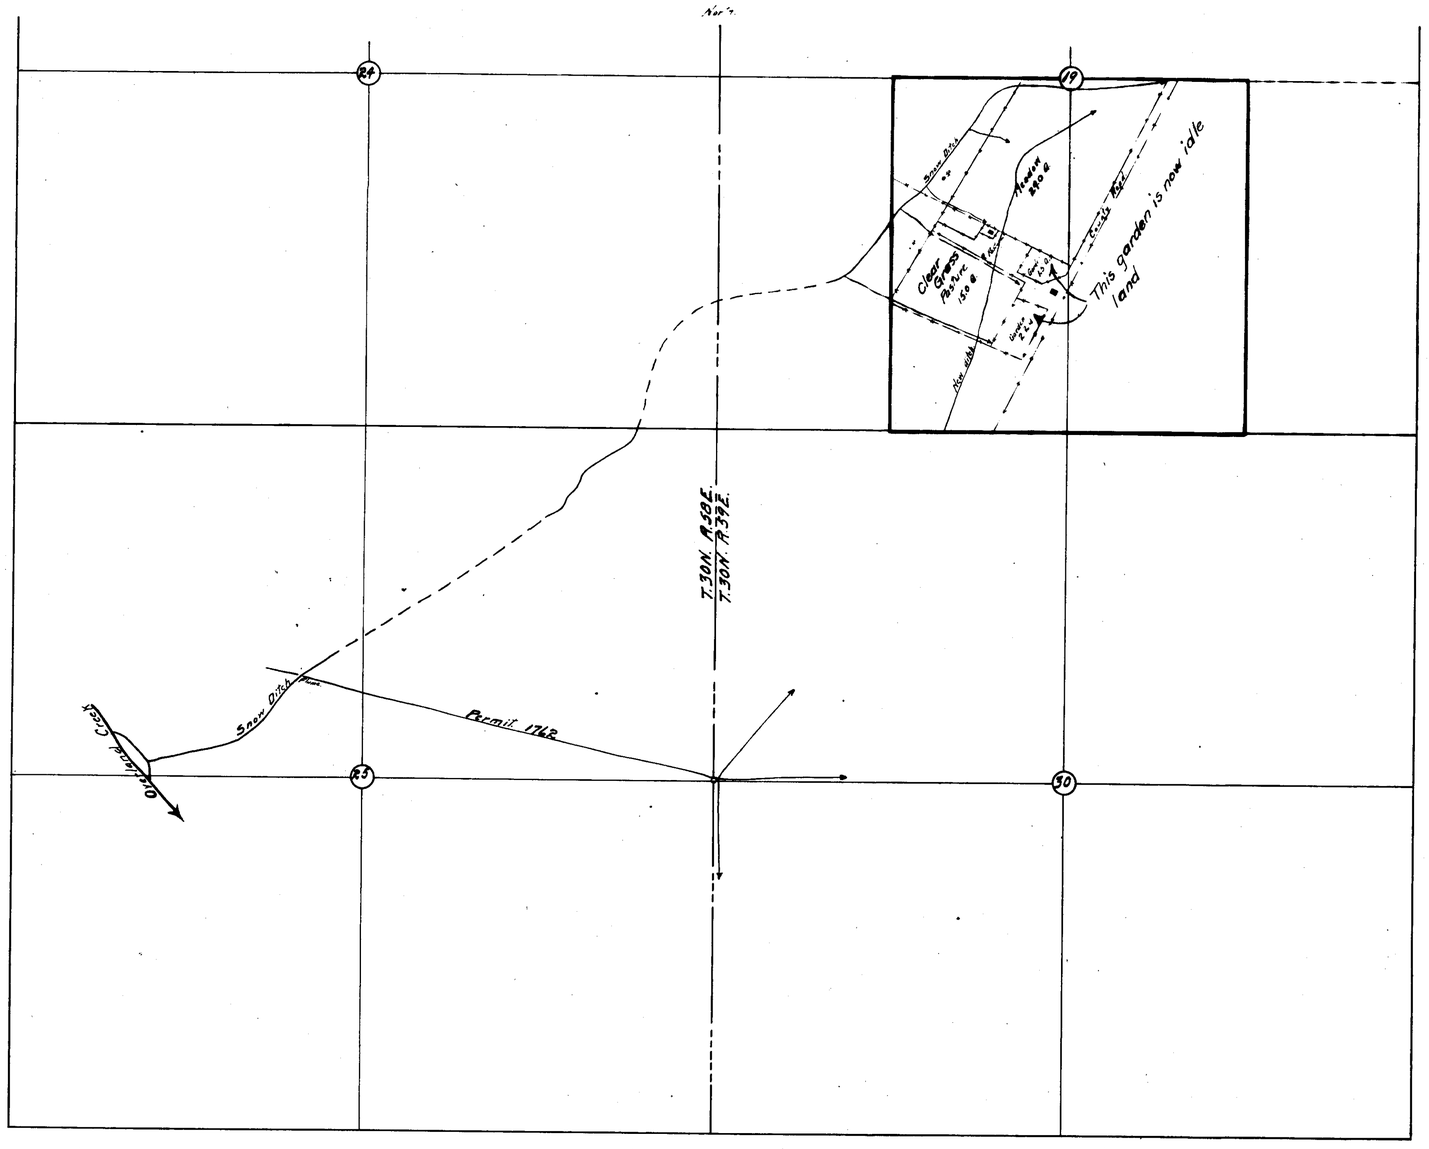

Checked in field May 24, 1921 by H. M. Payne and red ink notations made therefrom.

B.G. McBride
Crystal Land Company.

June 20. 28th
Crystal Land Company
Crystal Land Company.
B.G. McBride.

17th July 20 H.S. Taber.

Crystal Land Company.
Elko County Nevada
Overland Creek.
Scale 1" = 600' July 17-1920.

01724
01724