Section	Sub-division	Township	Range	Cultivated Acreage	Description of culture	Date of first culture
14	SW¼ SW¼	27 N.	43 E.	12.85	Wild Hay	
14	NW¼ SW¼	"	"	4.21	" "	
23	NW¼ NW¼	"	"	11.88	" "	
~~23~~	~~NE¼ NW¼~~	~~"~~	~~"~~	~~6.27~~	~~" "~~	
23	SW¼ NW¼	"	"	10.28	" "	
23	" "	"	"	15.61	Meadow Pasture	
23	NW¼ SW¼	"	"	34.00	Pasture	
23	SW¼ NW¼	"	"	3.05	"	
22	SE¼ NE¼	"	"	13.50	"	
22	NE¼ SE¼	"	"	20.92	"	
22	SE¼ SE¼	"	"	12.53	"	
~~14~~	~~NW¼ SW¼~~	~~"~~	~~"~~	~~21.03~~	~~Wild Hay~~	
15	SE¼ SE¼	"	"	15.06	" "	
15	NE¼ SE¼	"	"	21.02	" "	
22	NE¼ NE¼	"	"	6.40	" "	
22	SE¼ NE¼	"	"	12.65	" "	
				183.96		

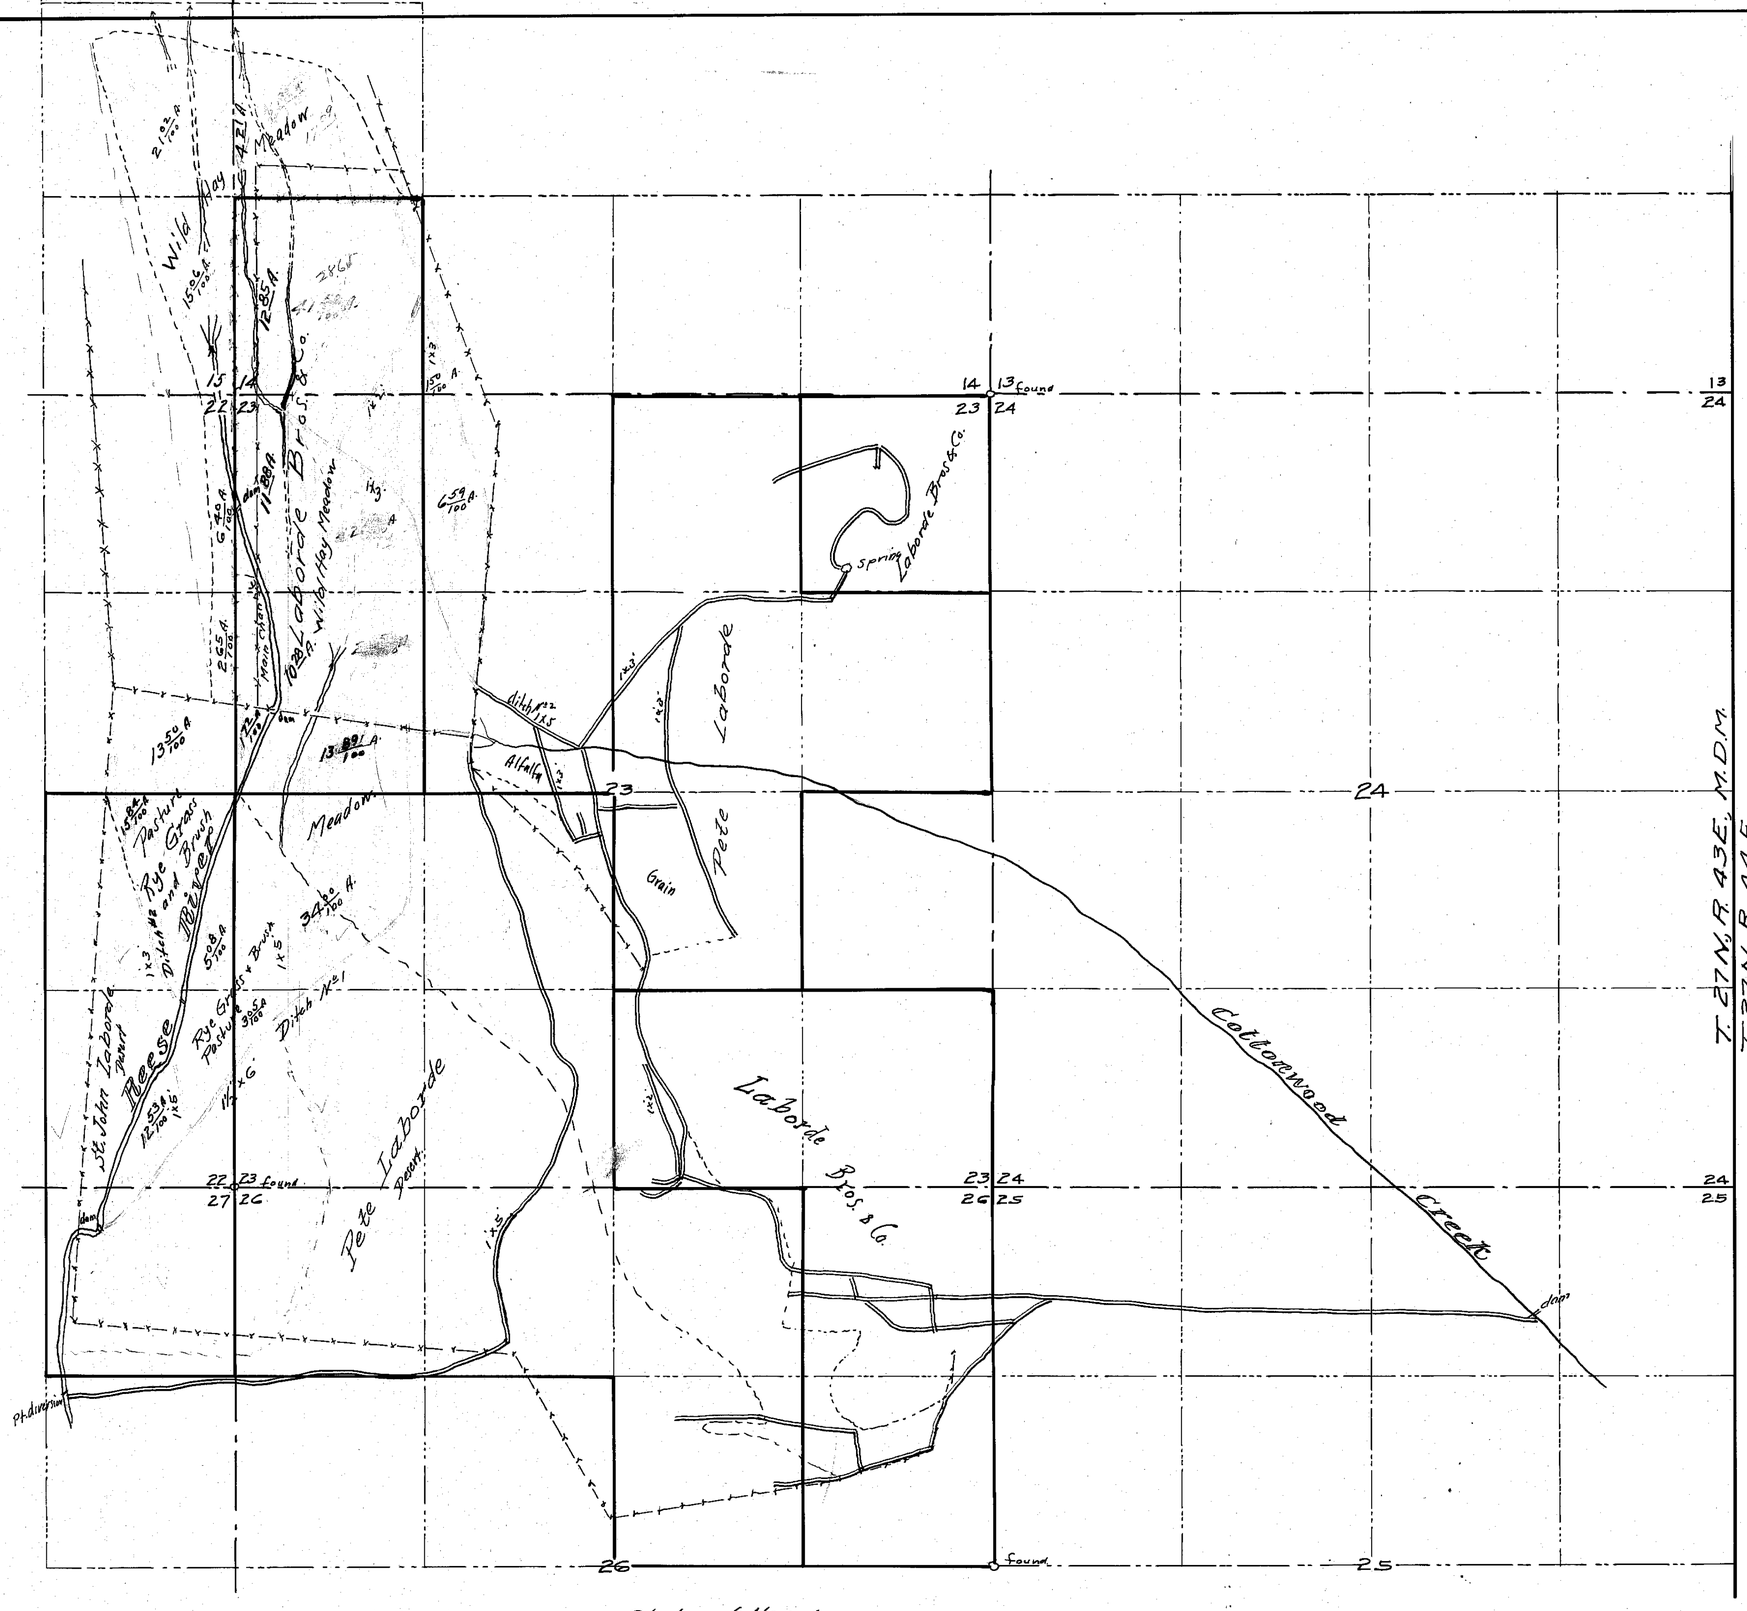

State of Nevada }
County of Humboldt } ss

I, H.H. Sheldon, being first duly sworn, depose and say that the above map is a true and accurate plat of the lands irrigated by Laborde Bros & Co., as taken from the field notes of a survey made by me, completed on 14th day of July, 1920.

That the map and survey were made at the instance of Laborde Bros. & Co., owner of said lands and that it truly represents the irrigated lands of said Laborde Bros. & Co.

H.H. Sheldon, C.E.
Surveyor.

Subscribed and sworn to before me, this 10th day of September, 1920

L.G. Wilson
Notary Public in and for Humboldt County, Nevada

Jan 18, 1921

MAP
OF
IRRIGATED LANDS
OF
LABORDE BROS. & CO.
FROM
REESE RIVER
LANDER COUNTY, NEVADA
SEPT. 1920, SCALE 1" = 600'

01749