Section	Subdivision	Township	Range	Acres	Culture	
13	SW¼ NW¼	43N	37E	5.80	Alfalfa	
"	" "	"	"	18.21	Pasture	
"	" "	"	"	0.92	Orchard	
"	SE¼ NW¼	"	"	20.03	Alfalfa	
"	" "	"	"	1.15	Orchard	
"	SW¼ NE¼	"	"	6.90	Alfalfa	
"	NW¼ SE¼	"	"	0.92	"	
"	NE¼ SW¼	"	"	8.55	"	
"	" "	"	"	1.15	Orchard	
"	NW¼ SW¼	"	"	1.26	"	
"	" "	"	"	2.30	Pasture	
"	" "	"	"	0.60	Alfalfa	
14	NW¼ NE¼	"	"	4.37	~~Pasture~~	D.P.
"	NE¼ NE¼	"	"	0.63	——	D.P.
"	SE¼ NE¼	"	"	18.96	"	
"	" "	"	"	16.88	Alfalfa	
"	SW¼ NE¼	#1 8.84	#2 1.38	10.22	——	D.P.
"	" "	"	"	18.05	~~Pasture~~	D.P.
"	NW¼ SE¼	"	"	23.31	Alfalfa	D.P.
"	NE¼ SE¼	#1 1.15	#2 10.86	12.01	"	
"	NE¼ SW¼	"	"	6.73	——	D.P.
"	SE¼ NW¼	"	"	0.57	——	D.P.
"	" "	"	"	8.63	~~Pasture~~	D.P.
"	NE¼ NW¼	"	"	2.61	——	D.P.
Total				190.76		

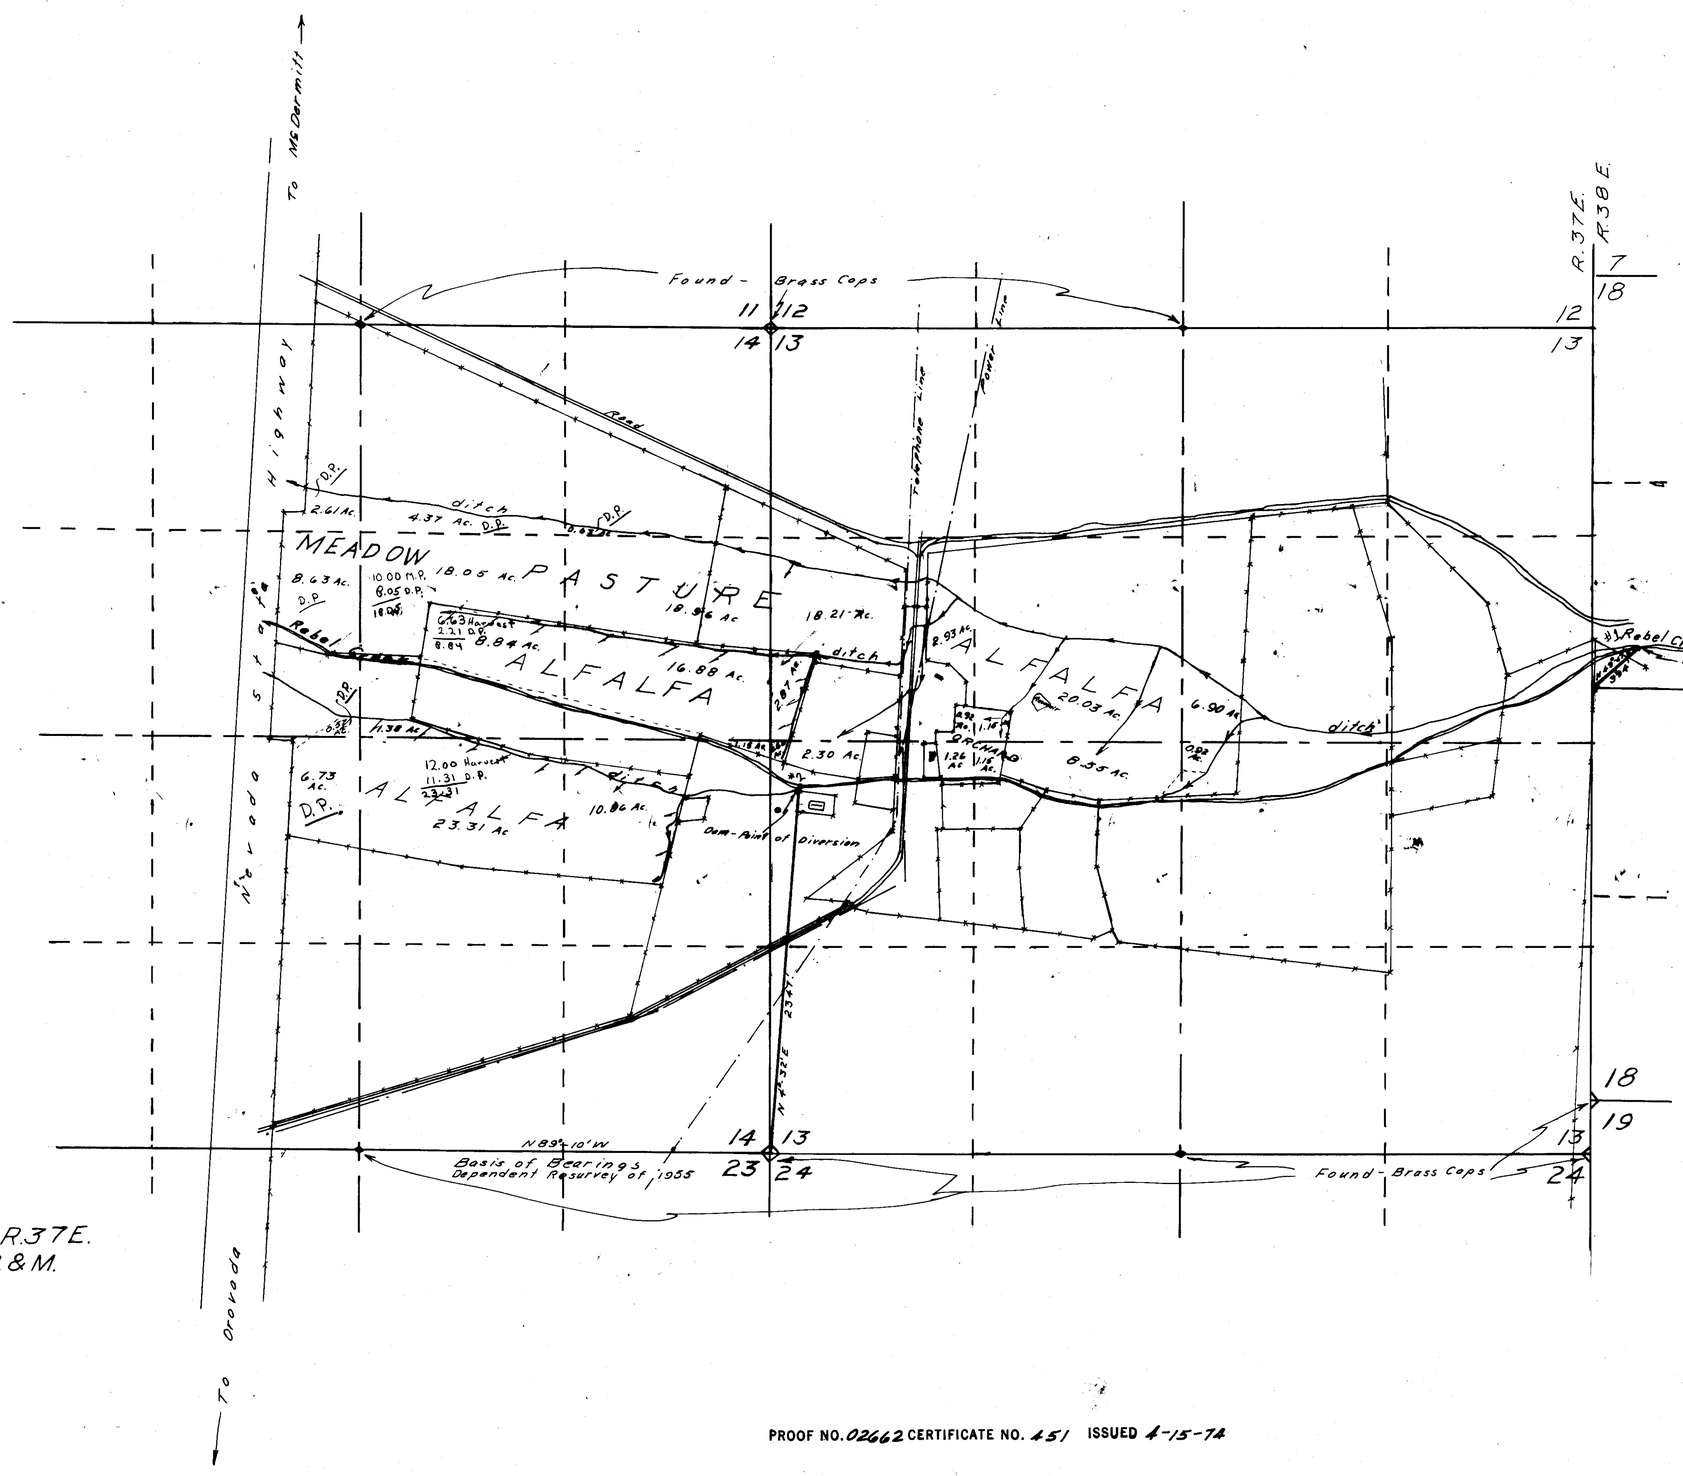

STATE OF NEVADA
COUNTY OF HUMBOLDT } S.S.

I, J. R. Caldwell, being first duly sworn, depose and say that this map has been correctly drawn to the designated scale from field notes of a survey made by me between the 28th day of July and the 7th day of August 1969; that it truly and correctly represents the location and extent of the works used to divert water from Rebel Creek in Humboldt County by N-J Ranches, Inc. for irrigation purposes. That all other works which are crossed by or connected with said works and the boundary, area and kind of culture of lands irrigated, are correctly shown and designated hereon.

J. R. Caldwell
State Water Resources Surveyor

REGISTERED LAND SURVEYOR - STATE OF NEVADA
J. R. CALDWELL
No. 626

Subscribed and sworn to before me this 14th day of August 1969.

Notary Public - State of Nevada
Humboldt County
My Commission Expires July 26, 1971

Scale 1" = 500'

500 0 500 1000 1500 2000

PROOF NO. 02662 CERTIFICATE NO. 451 ISSUED 4-15-74

OFFICE
STATE ENGINEER
1969 NOV 18 AM 10 20

FILED
Nov. 18, 1969
STATE ENGINEER'S OFFICE

(S)

MAP TO ACCOMPANY PROOF OF APPROPRIATION

BY N-J RANCHES, INC.
FOR IRRIGATION
FROM REBEL CREEK
IN HUMBOLDT COUNTY, NEVADA

02662