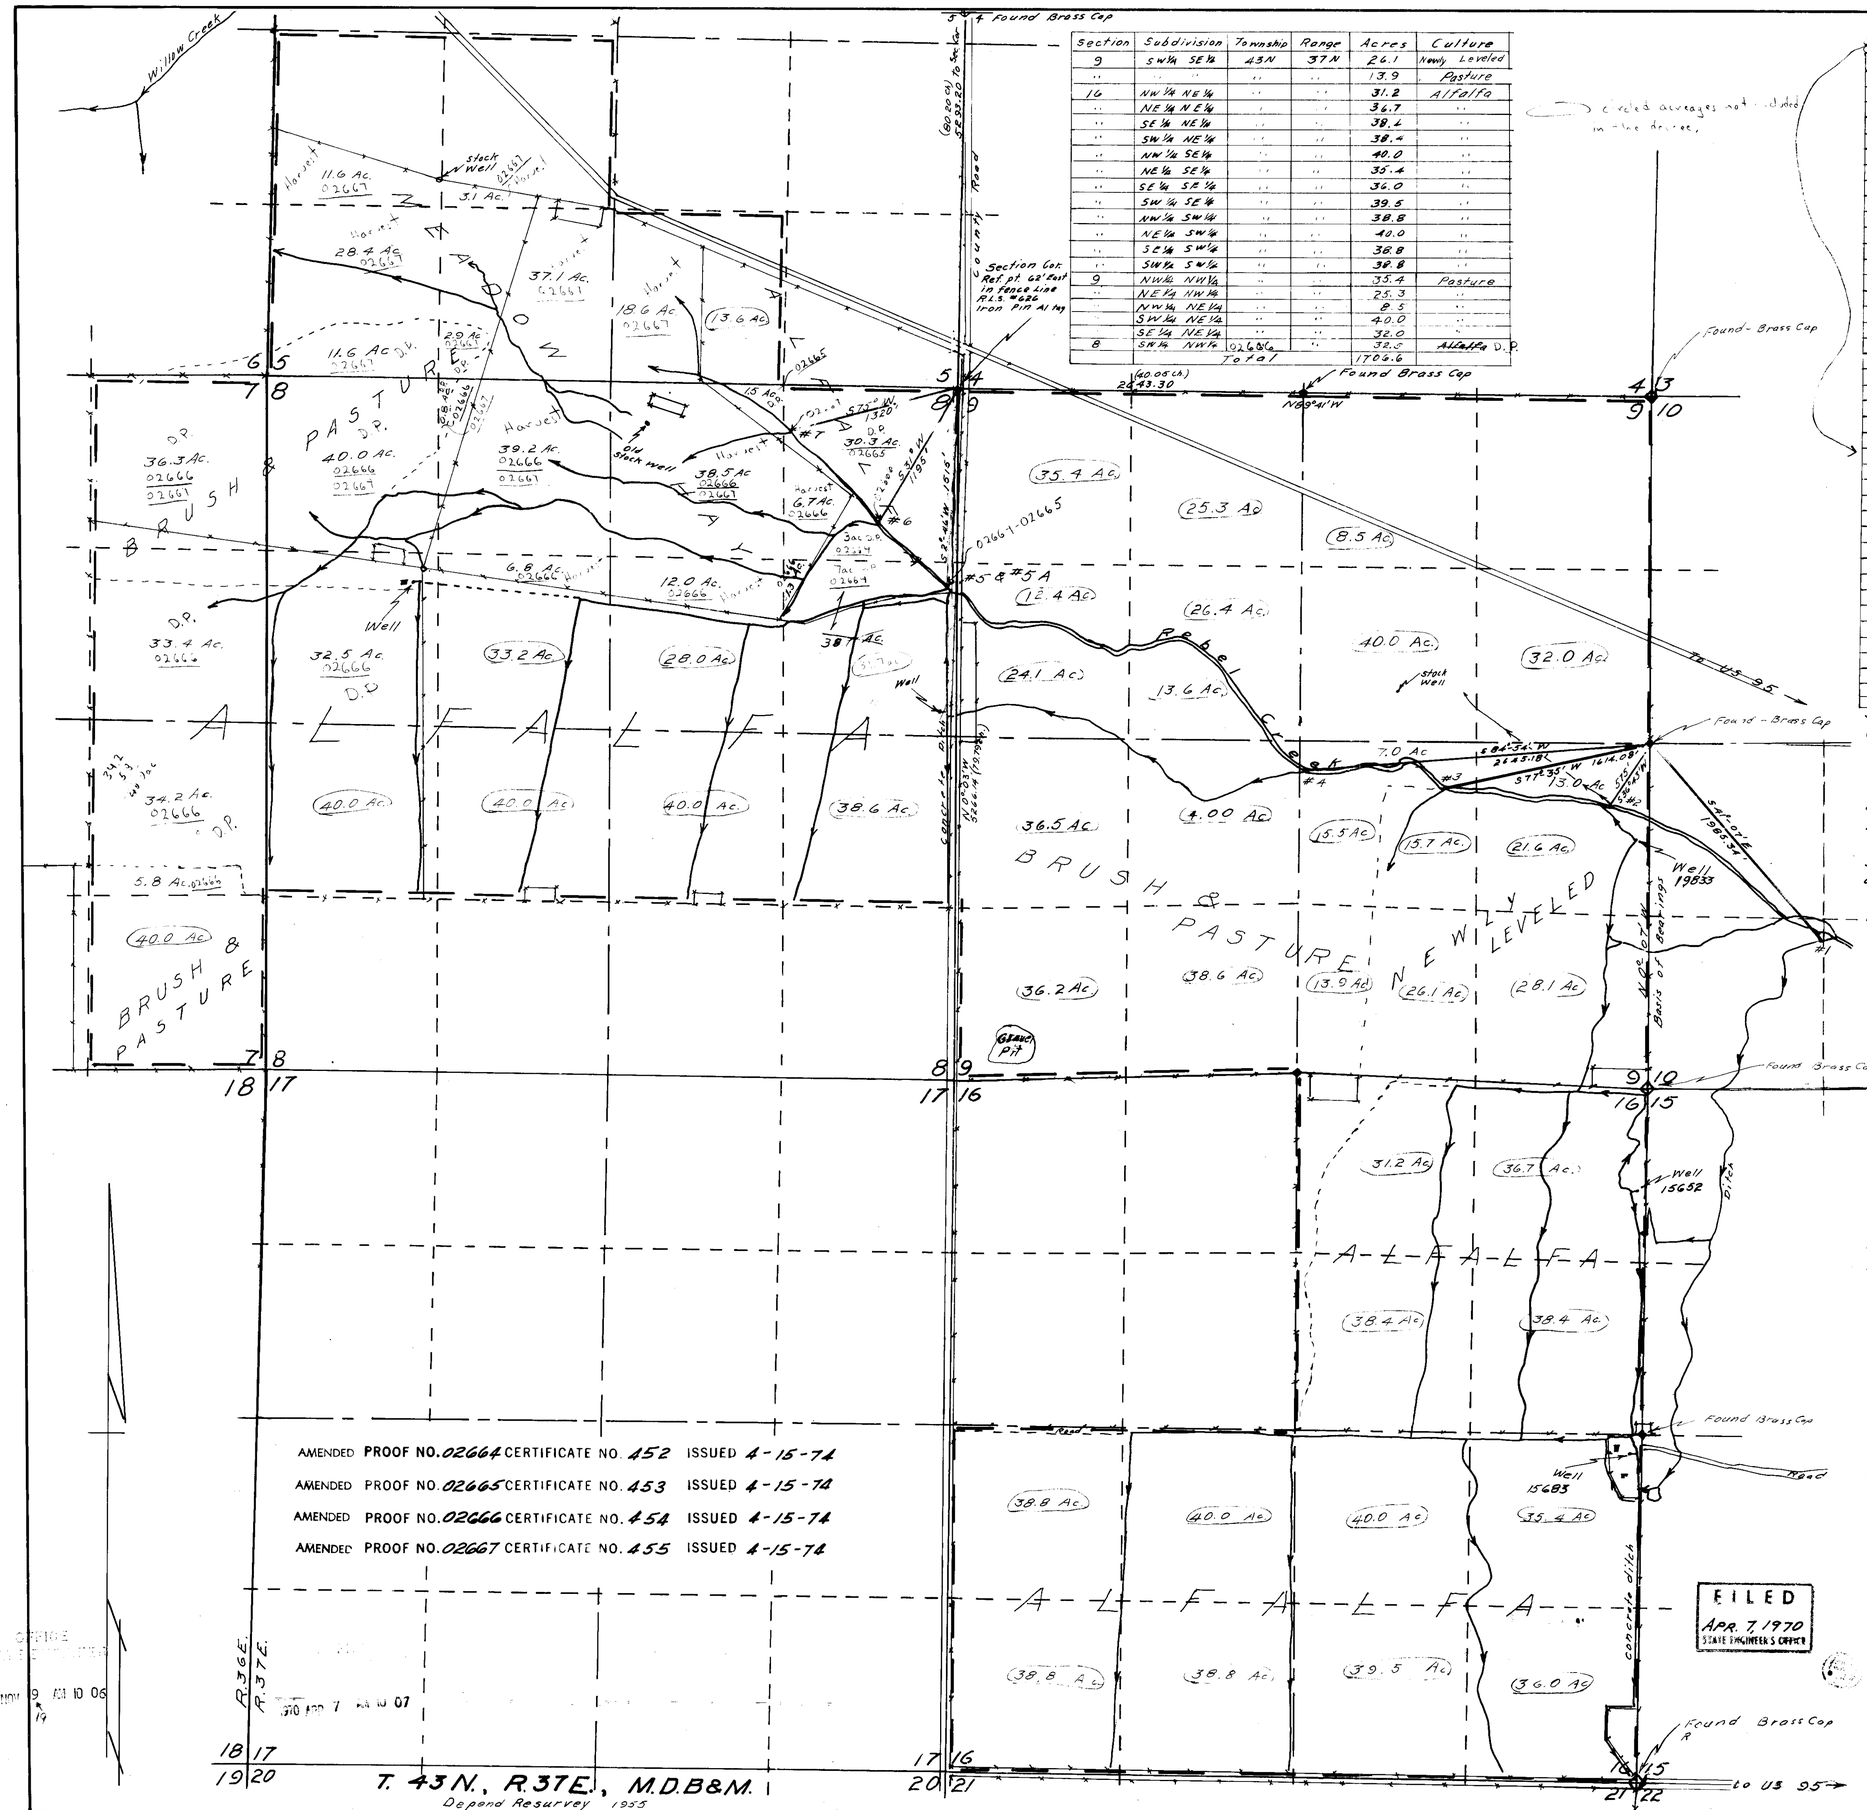

Section	Subdivision	Township	Range	Acres	Culture
9	SW¼ SE¼	43N	37N	26.1	Newly Leveled
"	" "	"	"	13.9	Pasture
16	NW¼ NE¼	"	"	31.2	Alfalfa
"	NE¼ NE¼	"	"	36.7	"
"	SE¼ NE¼	"	"	38.4	"
"	SW¼ NE¼	"	"	38.4	"
"	NW¼ SE¼	"	"	40.0	"
"	SE¼ SE¼	"	"	36.0	"
"	SW¼ SE¼	"	"	39.5	"
"	NW¼ SW¼	"	"	38.8	"
"	NE¼ SW¼	"	"	40.0	"
"	SE¼ SW¼	"	"	38.8	"
"	SW¼ SW¼	"	"	38.8	"
"	NE¼ NW¼	"	"	25.3	"
"	NW¼ NE¼	"	"	8.5	"
"	SW¼ NE¼	"	"	40.0	"
"	SE¼ NE¼	"	"	32.0	"
8	SW¼ NW¼	02666	"	32.5	~~Alfalfa~~ D.P.
	Total			1706.6	

8	NE¼NE¼	02664	"	3ac	D P
Section	Subdivision	Township	Range	Acres	Culture
5	NW¼ SW¼	43N 02667	37 E.	11.6	Meadow Hay Harvest
"	NE¼ SW¼	02667	"	3.1	" " Harvest
"	SE¼ SW¼	02667	"	37.1	" " Harvest
"	" "	02667	"	2.9	Brush & Pasture D.P.
"	SW¼ SW¼	02667	"	11.6	" D.P. "
"		02667	"	28.4	Meadow Hay Harvest
"	SW¼ SE¼	02667	"	18.6	Harvest
"	" "	"	"	13.6	Alfalfa
7	NE¼ NE¼	02666	02667	36.3	Brush & Pasture D.P.
"	SE¼ NE¼	02666	"	33.4	~~Alfalfa~~ D.P.
"	NE¼ SE¼	02666	"	34.2	——— D.P.
"	" "	02666	"	5.8	Brush & Pasture D.P.
"	SE¼ SE¼	"	"	40.0	" "
8	NW¼ NW¼	02666	02667	40.0	D. P. "
"	NE¼ NW¼	02666	02667	0.8	" D.P. "
"	" "	02666	02667	39.2	Meadow Hay Harvest
"	SE¼ NW¼	02666	"	6.8	Harvest
"	" "	"	"	33.2	Alfalfa
"	NW¼ SW¼	"	"	40.0	"
"	NE¼ SW¼	"	"	40.0	"
"	NW¼ SE¼	"	"	40.0	"
"	NE¼ SE¼	"	"	38.6	"
"	NW¼ NE¼	02665	"	1.5	D. P.
"	" "	02666	02667	38.5	Meadow Hay Harvest
"	NE¼ NE¼	02666	"	6.7	Harvest
"	" "	02665 02667, 3ac D.P.	"	39.3	~~Alfalfa~~ D.P.
"	SE¼ NE¼	"	"	38.7	"
"	" "	02666	"	1.3	Meadow Hay Harvest
"	SW¼ NE¼	02666	"	12.0	Harvest
"	" "	"	"	28.0	Alfalfa
9	SW¼ NW¼	"	"	36.5	Brush & Pasture
"	SE¼ NW¼	"	"	40.0	" "
"	NW¼ SW¼	"	"	36.5	" "
"	NE¼ SW¼	"	"	40.0	" "
"	SE¼ SW¼	"	"	38.6	" "
"	SW¼ SW¼	"	"	36.2	" "
"	NW¼ SE¼	"	"	22.5	" "
"	" "	"	"	15.7	Newly Leveled
"	NE¼ SE¼	"	"	21.6	" "
"	SE¼ SE¼	"	"	28.1	" "
"	NE¼ SE¼	"	"	13.0	Pasture

circled acreages not included in the decree.

STATE OF NEVADA }
COUNTY OF HUMBOLDT } S.S.

I, J. R. Caldwell, being first duly sworn, depose and say that this map has been correctly drawn to the designated scale from field notes of a survey made by me between the 15th day of August and the 17th day of November 1969, that it truly and correctly represents the location and extent of the works used to divert water from Rebel Creek in Humboldt County by Western States Cattle Co. for Irrigation purposes. That all other works which are crossed by or connected with said works and the boundary, area and kind of culture of lands irrigated, are correctly shown and designated hereon.

J R Caldwell
State Water Right Surveyor

J. R. CALDWELL
REGISTERED LAND SURVEYOR
NEVADA

Subscribed and sworn to before me this 1st day of November, 1969.

Carol M. Acre

Scale 1" = 600'

600 0 600 1200 1800 2400

AMENDED PROOF NO. 02664 CERTIFICATE NO. 452 ISSUED 4-15-74
AMENDED PROOF NO. 02665 CERTIFICATE NO. 453 ISSUED 4-15-74
AMENDED PROOF NO. 02666 CERTIFICATE NO. 454 ISSUED 4-15-74
AMENDED PROOF NO. 02667 CERTIFICATE NO. 455 ISSUED 4-15-74

FILED
APR. 7, 1970
STATE ENGINEER'S OFFICE

MAP TO ACCOMPANY PROOF OF APPROPRIATION

BY WESTERN STATES CATTLE CO.
FOR IRRIGATION
FROM REBEL CREEK
IN HUMBOLDT COUNTY, NEVADA

83527 83526 83525 83524 02667, 02666, 02665, 02664, 02663 — File Under