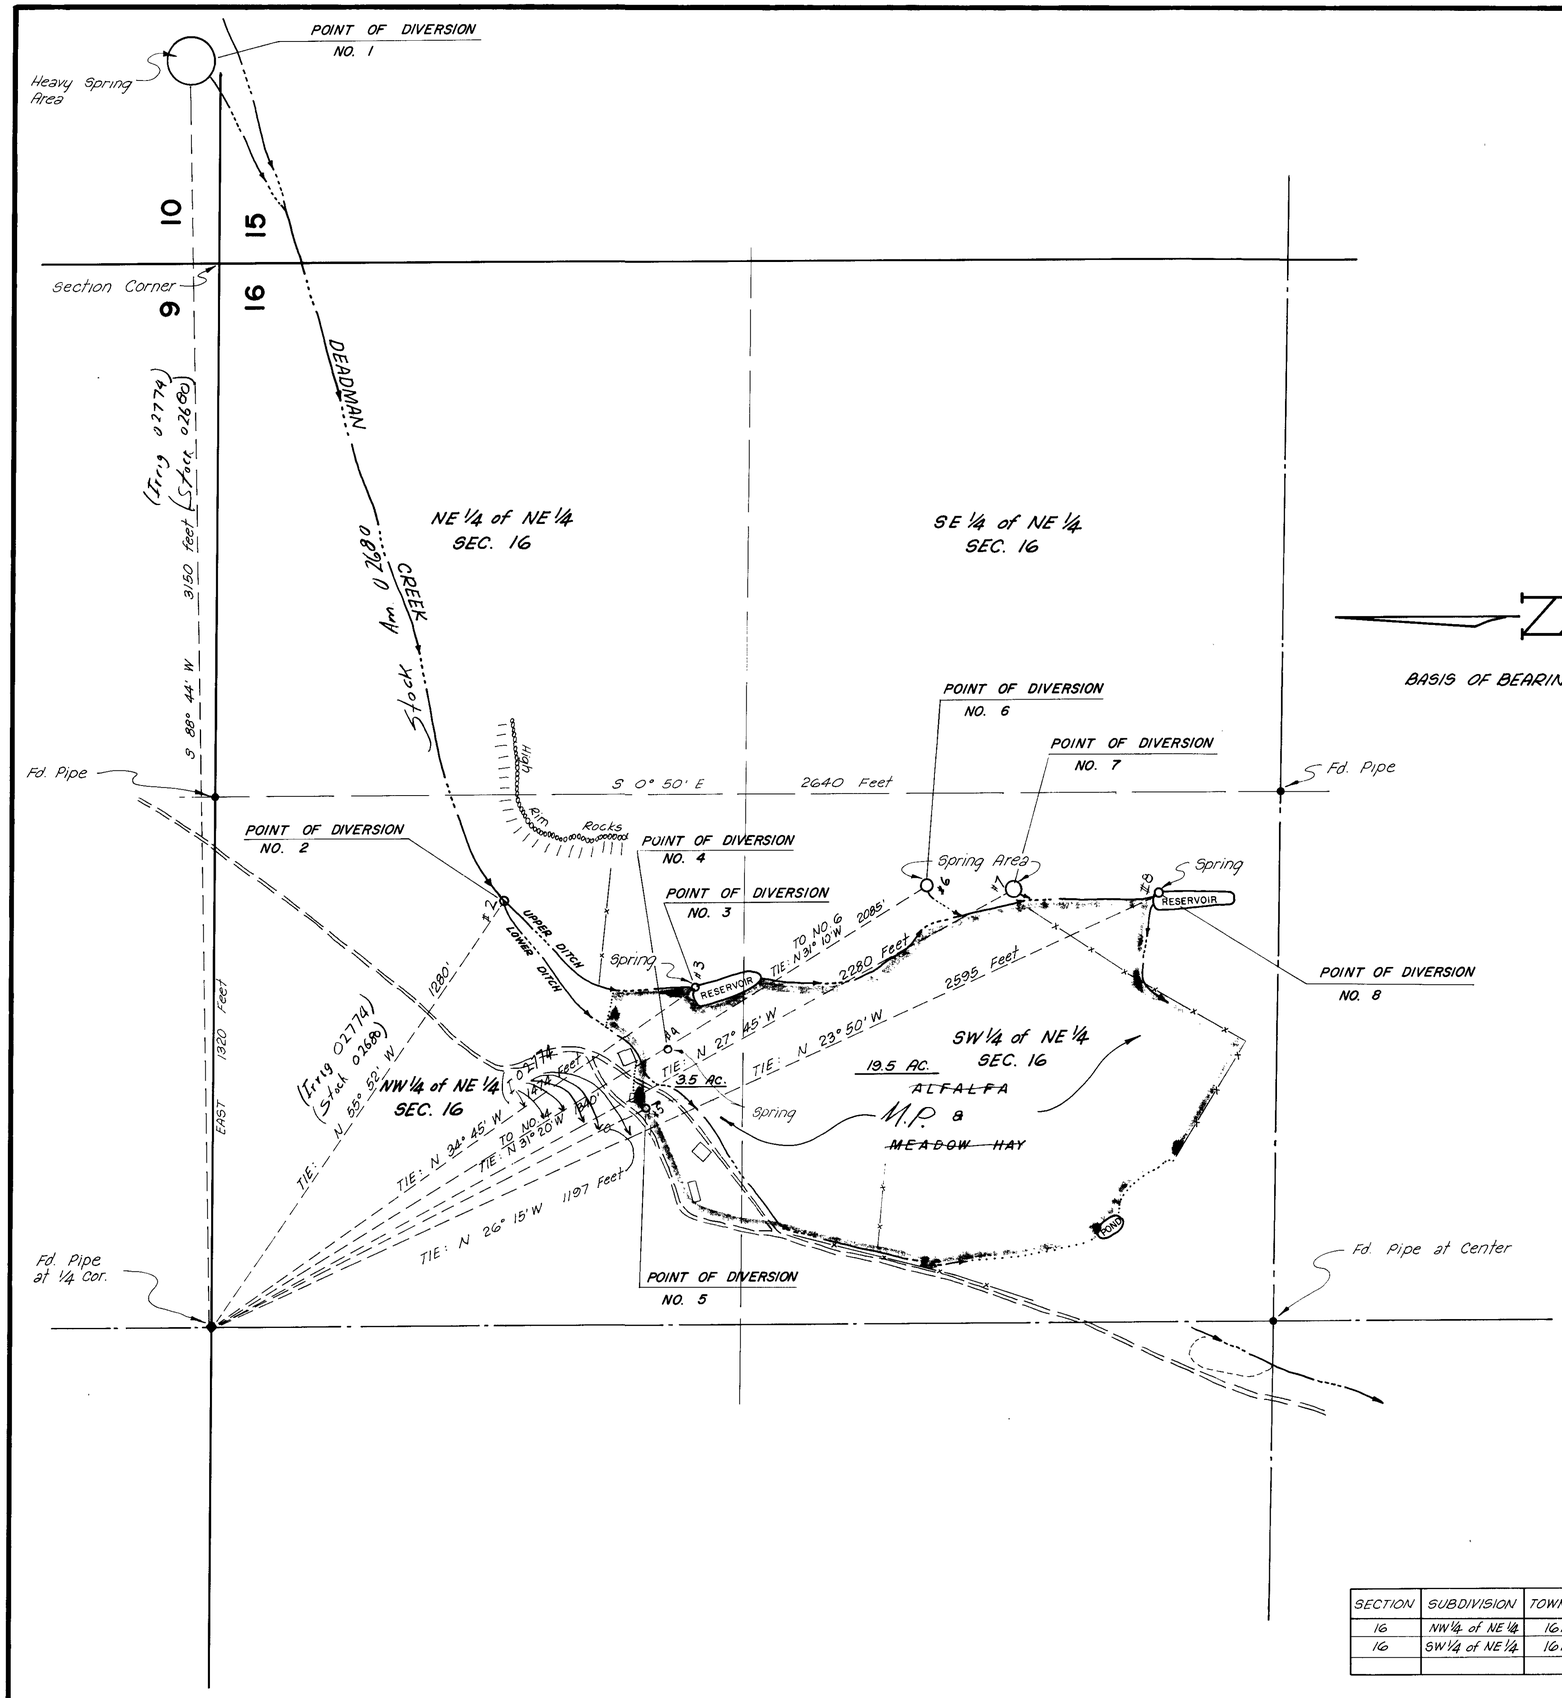

BASIS OF BEARINGS : Magnetic North

STATE OF NEVADA
COUNTY OF WASHOE S. S.

I, E.P. Osgood, Jr., being first duly sworn, depose and say, that this map, consisting of 1 sheet has been correctly drawn to the designated scale from field notes of a survey made by E.P. Osgood, Sr. on the 17th and 18th days of August, 1954, and again by me on March 25th, 1968. That it truly and correctly represents the location and extent of the works used to divert water from Deadman's Canyon Creek and tributaries for irrigation, stock water, and domestic uses by Carol Janulis. That all other works or streams which are crossed by or connected with said works, and the boundary, area and kind of culture of lands irrigated, are correctly shown and designated hereon.

E.P. Osgood Jr.
E.P. Osgood, Jr.
State Water Right Surveyor No. 294

* Does not signature on linen, signed in blue ink and did reproduce on this cronar L.E.P.

Subscribed to and sworn to before me on this ___ day of _____, 1972.

_____
* Notary Public

Notary Public in and for Washoe County, Nevada.
My commission expires : _____

April 9, 1972

SCALE 1" = 200'

0 200 400 600 800

SECTION	SUBDIVISION	TOWNSHIP	RANGE	CULTIVATED ACREAGE	DESCRIPTION OF CULTURE
16	NW 1/4 of NE 1/4	16N	20E	3.5	~~ALFALFA AND~~
16	SW 1/4 of NE 1/4	16N	20E	19.5	~~MEADOW HAY~~
					M.P.

MAP TO ACCOMPANY
PROOF OF APPROPRIATION OF WATER
FOR IRRIGATION, STOCK WATER, AND DOMESTIC USE
BY
CAROL JANULIS (Scripps)
FROM DEADMAN'S CANYON CREEK AND TRIBUTARIES
MARCH 1972
E.P. OSGOOD, JR., ST. WTR. RT. SUR. NO. 294

02774, 02680 ← Filed under