STATE OF NEVADA

SS.

COUNTY OF ELKO

I, William A. Nisbet, being first duly sworn, depose and say that this map, consisting of one sheet, has been correctly drawn to the designated scale from field notes of a survey made by me, or under my supervision and direction, on the 2nd day of June, 1994, and also certain aerial photographs of the Soil Conservation Service; that it truly and correctly represents the existing location and extent of the works used to divert water from HANKS CREEK, OWYHEE RIVER and SPRINGS and TRIBUTARIES, in Elko County, by ELIAS FERNANDO GOICOECHEA FAMILY TRUST AGREEMENT. for IRRIGATION, STOCKWATER AND DOMESTIC purposes. That the existing points of diversion, the approximate location and size of the diverting channel, all reservoirs or basins, the location and names of all other works which cross or connect with the existing works, and the boundary of all lands, showing by 40-acre subdivisions the areas irrigated, are fully and correctly designated thereon.

William A. Nisbet

STATE WATER RIGHT SURVEYOR NO. 448

PROFESSIONAL LAND SURVEYOR STATE OF NEVADA
WILLIAM A. NISBET
10/11/94
No. 3805

Subscribed and sworn to before me this 11 day of Oct 1994

Coralee Griswold

NOTARY PUBLIC in and for ELKO COUNTY, NEVADA

CORALEE GRISWOLD
NOTARY PUBLIC
STATE OF NEVADA
ELKO COUNTY
My Comm. Expires JUL 12, 1998

N

T. 42 N., R. 55 E., M.D.M.

BASIS OF BEARING: Magnetic, var. 16°E

HANKS CREEK – PROOF 06767

SECTION	SUB-DIVISION	TOWNSHIP	RANGE	CULTIVATED ACREAGE	DESCRIPTION OF CULTURE	DATE OF FIRST CULTURE
1	LOT 6	T 42 N	R 55 E	16.45	MEADOW HAY	1897
1	LOT 7	"	"	2.67	"	1897
2	LOT 1	"	"	10.91	"	1897
2	LOT 2	"	"	.65	"	1897
2	SE NE	T 42 N	R 55 E	7.29	"	1897
TOTAL ACRES				37.97		

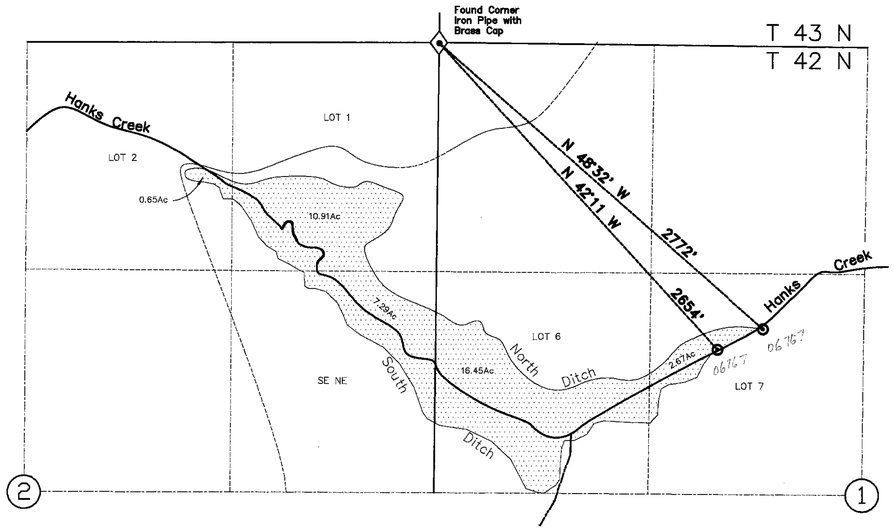

T. 42 N., R. 55 E., M.D.M.

OWYHEE RIVER – PROOF 06768

SECTION	SUB-DIVISION	TOWNSHIP	RANGE	CULTIVATED ACREAGE	DESCRIPTION OF CULTURE	DATE OF FIRST CULTURE
9	NE SW	T 42 N	R 55 E	5.93	MEADOW HAY	1897
9	NW SE	"	"	12.63	"	1897
9	SE SE	"	"	19.32 ~~16.29~~ NW/4 SE/4	"	1897
9	NE SE	"	"	16.29 ~~19.32~~ NW/4 SE/4	"	1897
10	SW SW	"	"	.50	"	1897
15	NW NW	"	"	.33	"	1897
16	NE NE	T 42 N	R 55 E	.21	"	1897
TOTAL ACRES				55.21		

T. 42 N., R. 55 E., M.D.M.

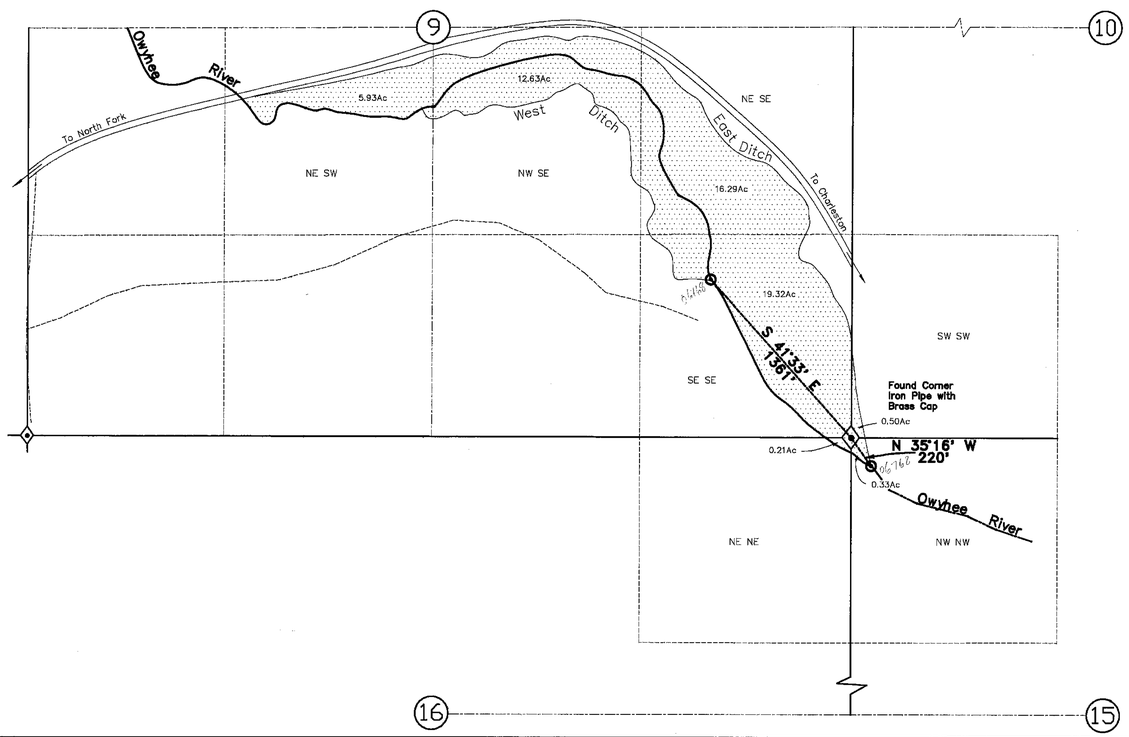

LEGEND

- SPRING
- DITCH
- CREEK OR RIVER
- ROAD
- SECONDARY ROAD
- MEADOW HAY
- POINT OF DIVERSION

'94 OCT 13 P2:24
STATE ENGINEER'S OFFICE

500 0 500 1000

SCALE: 1"=500'

FILED
OCT 13 1994
STATE ENGINEER'S OFFICE

NO.	BY	DATE	DESCRIPTION	CHK'D	APP'D

REVISIONS

DRAWN BY DJH | APPROVED BY WAN
JOB NO. 2105.001 | DATE AUG.1994

MAP TO ACCOMPANY
PROOF OF APPROPRIATION
#06767 and #06768
IRRIGATION, STOCKWATER
& DOMESTIC PURPOSES

FOR
BY **Elias Fernando Goicoechea Family Trust Agreement**
FROM OWYHEE RIVER, HANKS CREEK
IN and SPRINGS and TRIBUTARIES
ELKO COUNTY, NEVADA

CHILTON Engineering and Surveying, LTD
421 Court Street
(702) 738-2121 Elko, Nevada 89801

W94027 1/1

06768 06767