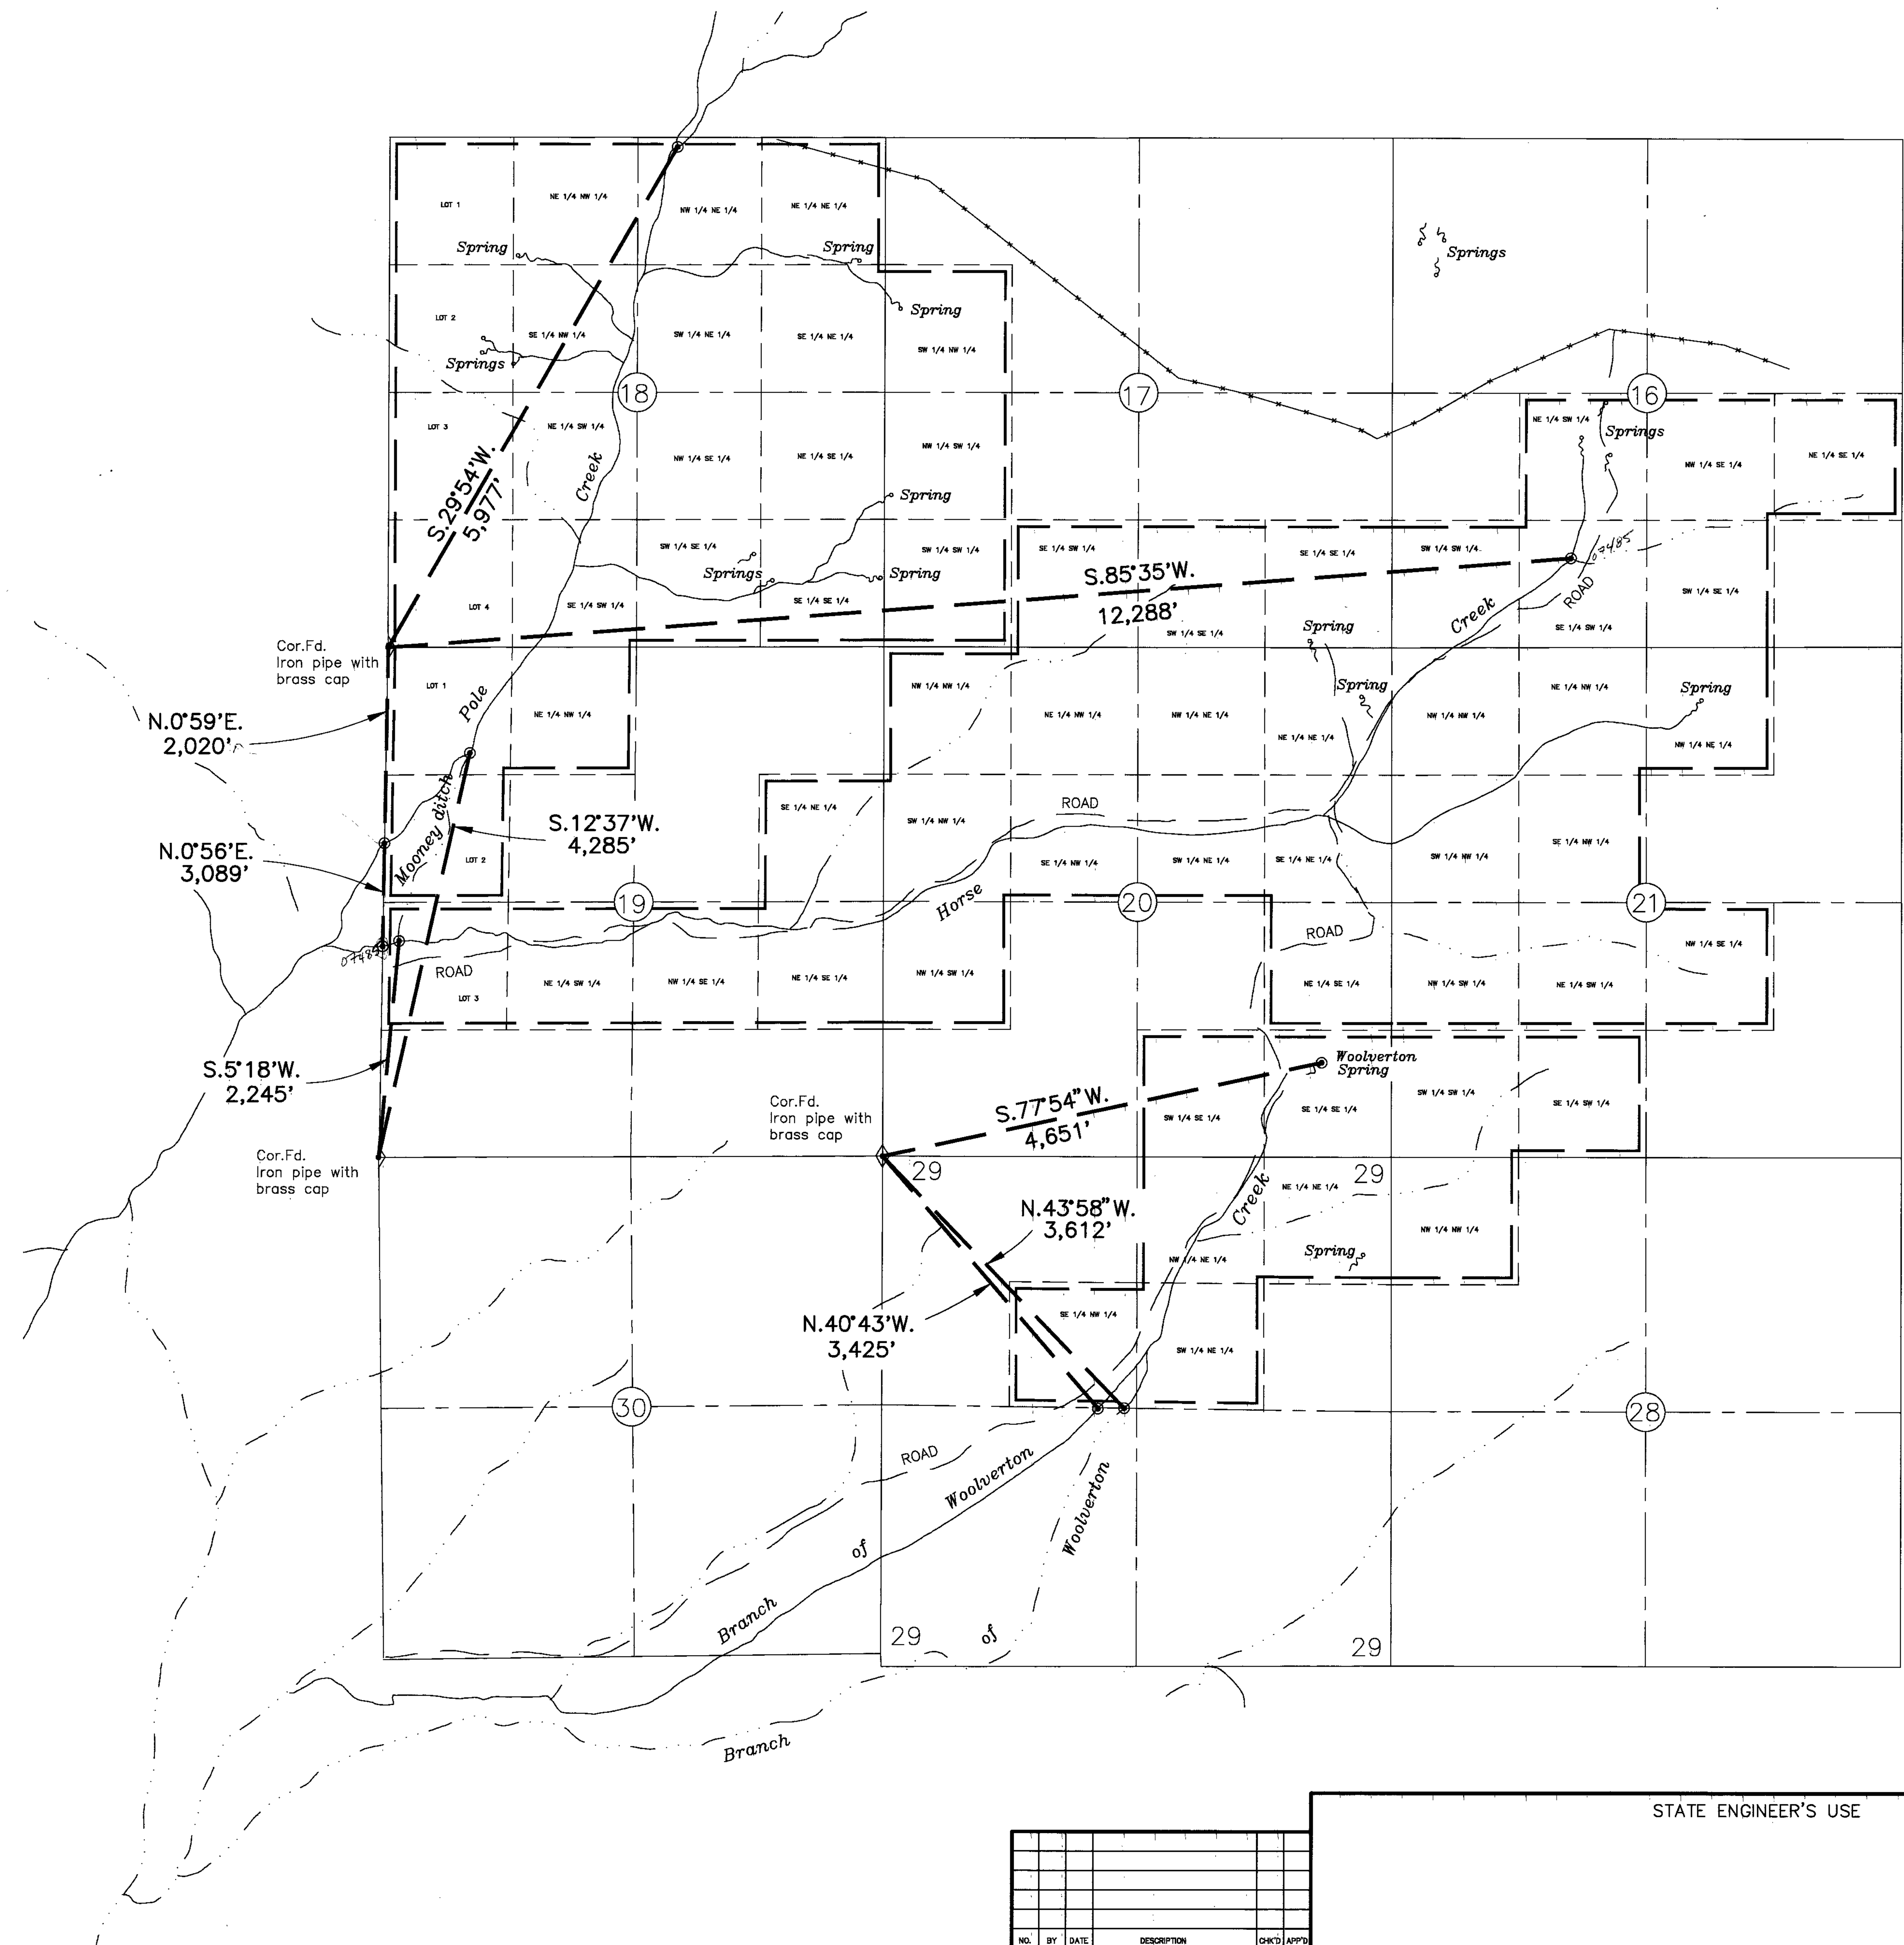

N

T.34N.,R.61E.
M.D.M.

STATE OF NEVADA }
} s.s.
COUNTY OF ELKO }

I, William A. Nisbet, being first duly sworn, depose and say that this map, consisting of one sheet, has been correctly drawn to the designated scale from a field survey made under my supervision and direction, completed on the 16th day of June, 1995; and from information shown on pertinent quadrangle maps published by the U.S. Geological Survey; that it truly and correctly represents the proposed location and extent of the works used to divert water from SURFACE SOURCES in ELKO COUNTY by DUVAL RANCHING COMPANY and S AND D COMPANY for STOCKWATERING AND DOMESTIC PURPOSES. That the proposed points of diversion, the approximate location and names of all other works or streams which are crossed by, or connected with the said works, are fully and correctly designated thereon.

PROFESSIONAL LAND SURVEYOR - STATE OF NEVADA
WILLIAM A. NISBET
12/22/95
No. 3805

William A. Nisbet

STATE WATER RIGHT SURVEYOR NO. 448

Subscribed and sworn to before me this 22 day of Dec 1995 by William A. Nisbet.

CORALEE GRISWOLD
My Comm. Expires JUL 12, 1998

Coralee Griswold

NOTORY PUBLIC in and for ELKO COUNTY, NEVADA

BASIS OF BEARING: Magnetic, Var. 16° E.

LEGEND

- ROAD
- FENCE
- TIE LINE
- PLACE OF USE BOUNDARY
- PRIMARY CREEKS
- SECONDARY CREEKS
- SECTION CORNER
- POINT OF DIVERSION

0 ~~1000~~ 500 ~~2000~~ 1,000 ~~4000~~ 2,000 WAN
SCALE: 1"=~~2000'~~ 1,000

07480-85

NO.	BY	DATE	DESCRIPTION	CHK'D	APP'D

REVISIONS

DRAWN BY JFP | APPROVED BY WAN
JOB NO. 2099.002 | DATE 11-15-95

CHILTON Engineering and Surveying, LTD
(702) 738-2121 421 Court Street Elko, Nevada 89801

W95031 1/1

STATE ENGINEER'S USE

FILED
FEB 13 1997
STATE ENGINEER'S OFFICE

STATE ENGINEER'S OFFICE
96 JAN -2 AM 12:14
RECEIVED

(S)

MAP TO ACCOMPANY
PROOF OF APPROPRIATION
FOR STOCKWATERING AND DOMESTIC PURPOSES
BY **DUVAL RANCHING COMPANY**
AND **S AND D COMPANY**
FROM POLE, HORSE, WOOLVERTON CREEKS AND SPRINGS AND TRIBUTARIES
IN ELKO COUNTY

W95031

07485 07484 07483 07482 07481 07480

W95031 Fri Dec 22 13:20:44 1995