TRUCKEE RIVER CLAIMS 178.5, 179.5, 205, 206, and 259

PORTION OF SECTION 25, T.19 N., R.19 E., M.D.B.&M.

This map is solely for the purpose of describing acreage to which water rights were allocated by the final decree in the United States vs. Orr Water Ditch Company, in Equity, Docket No. A3 and for no other purpose. The map is based upon the State Engineer's and the Federal Water Master's interpretation of the final decree using information available in the State Engineer's and the Federal Water Master's office as of the date of this approval. This map should not be relied upon as a legal description of any specific parcel.

APPROVED BY THE STATE ENGINEER:

s/R. Michael Turnipseed, P.E. 5/11/00
R. Michael Turnipseed, P.E. Date

APPROVED BY THE FEDERAL WATER MASTER:

s/Garry D. Stone 5/16/00
Garry D. Stone Date

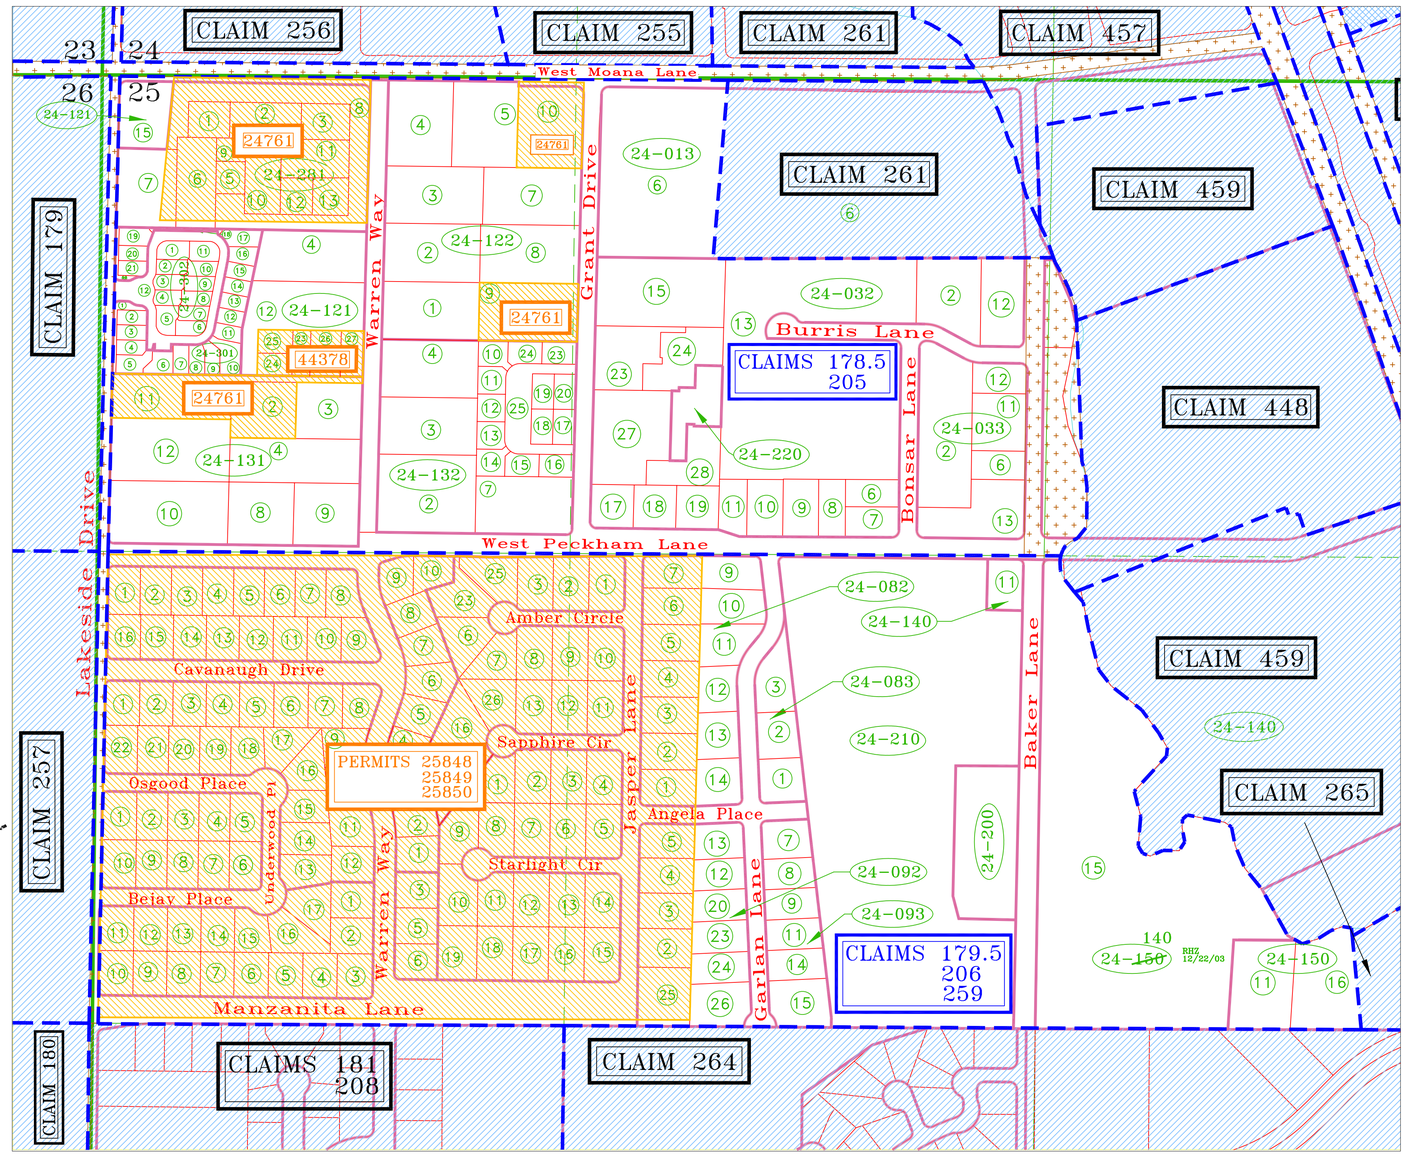

CLAIMS 178.5 and 205

PARCEL	AREA (acres)
24-013-06	3.67
24-032-02	0.87
24-032-06	0.26
24-032-07	0.29
24-032-08	0.28
24-032-09	0.37
24-032-10	0.37
24-032-11	0.28
24-032-12	0.69
24-032-13	6.80
24-032-15	1.58
24-032-17	0.34
24-032-18	0.33
24-032-19	0.33
24-032-23	0.70
24-032-24	0.64
24-032-27	1.22
24-032-28	0.54
24-033-02	1.52
24-033-06	0.28
24-033-11	0.56
24-033-12	0.30
24-033-13	0.86
24-121-04	1.00
24-121-12	1.14
24-121-15	0.62
24-122-01	1.00
24-122-02	1.01
24-122-03	1.00
24-122-04	1.00
24-122-05	1.00
24-122-07	1.00
24-122-08	1.04
24-131-03	0.65
24-131-04	1.03
24-131-08	0.74
24-131-09	0.74
24-131-10	1.34
24-131-12	1.34
24-132-02	1.38
24-132-03	1.00
24-132-04	1.00
24-132-07	1.00
24-132-10	0.14
24-132-11	0.14
24-132-12	0.14
24-132-13	0.14
24-132-14	0.14
24-132-15	0.14
24-132-16	0.14
24-132-17	0.14
24-132-18	0.14
24-132-19	0.14
24-132-20	0.14
24-132-23	0.14
24-132-24	0.14
24-132-25	0.57
24-220-00	0.55
24-281-06	0.06
24-281-07	0.67
24-281-08	0.23
24-301-01	0.08
24-301-02	0.08
24-301-03	0.08
24-301-04	0.08
24-301-05	0.11
24-301-06	0.11
24-301-07	0.09
24-301-08	0.08
24-301-09	0.09
24-301-10	0.14
24-301-11	0.08
24-301-12	0.08
24-301-13	0.08
24-301-14	0.08
24-301-15	0.08
24-301-16	0.09
24-301-17	0.11
24-301-18	0.03
24-301-19	0.10
24-301-20	0.08
24-301-21	0.08
24-301-22	0.05
24-302-01	0.11
24-302-02	0.08
24-302-03	0.09
24-302-04	0.08
24-302-05	0.11
24-302-06	0.08
24-302-07	0.08
24-302-08	0.08
24-302-09	0.08
24-302-10	0.08
24-302-11	0.11
24-302-12	0.71
BONSAR LANE	0.65
BURRIS LANE	0.81
GRANT DRIVE	1.48
~~MANZANITA LANE~~	~~0.76~~ 0.00
WARREN WAY	1.44
W. MOANA LANE	0.47
W. PECKHAM LANE	~~1.94~~ 2.70
PERMIT 24761 (CERT. #7244)	9.00
PERMIT 44378 (CERT. #11140)	0.87
TOTAL =	68.00 acres

CLAIMS 179.5, 206, and 259

PARCEL	AREA (acres)
24-082-09	0.36
24-082-10	0.41
24-082-11	0.40
24-082-12	0.32
24-082-13	0.35
24-082-14	0.36
24-083-01	0.35
24-083-02	0.34
24-083-03	0.41
24-092-12	0.28
24-092-13	0.32
24-092-20	0.30
24-092-23	0.32
24-092-24	0.35
24-092-25	0.06
24-092-26	0.47
24-093-07	0.34
24-093-08	0.28
24-093-09	0.29
24-093-11	0.31
24-093-14	0.33
24-093-15	0.54
24-140-11	0.33
24-140-15	11.26
24-150-11	1.00
24-150-16	1.08
24-200-00	1.73
24-210-00	15.91
ANGELA PLACE	0.36
BAKER LANE	~~1.87~~ 1.75
GARLAN LANE	1.66
~~MANZANITA LANE~~	~~1.07~~ 0.48
WEST PECKHAM LANE	1.07
PERMIT 25848 (CERT. #8719)	13.30
PERMIT 25849 (CERT. #8720)	22.90
PERMIT 25850 (CERT. #8721)	13.30
TOTAL =	93.20 acres

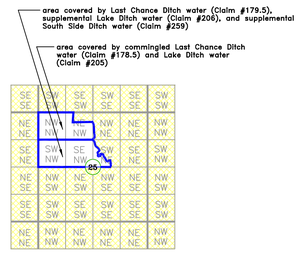

PORTION OF SECTION COVERED BY THIS SHEET

LEGEND

- lot/parcel line
- block boundary
- section / 1/4 section / 1/4 1/4 section — Public Land Survey System (PLSS) lines
- creek/ditch
- area covered by decreed water rights
- dry area not containing decreed water rights
- claim coverage on other sheet
- 99-999 (block, page, book) 99 (lot number) — Washoe County Assessor's parcel number (APN)
- found section corner
- water rights completely stripped by permit/certificate

200 0 100 200 400
SCALE

CHECKED BY	
SECTION CHIEF	TWT
PROJECT SUPERVISOR	RHZ
F.W.M. OFFICE REVIEWER	JMP

STATE of NEVADA
Division of Water Resources
123 W. Nye Ln., Carson City NV 89710

DRAWING NO.: TR-071
DRAWN BY: AES, TAH, DTT DATE: 4-25-2000