TRUCKEE RIVER CLAIMS 201, 236–241
PORTIONS OF SECTION 14
T. 19 N., R. 19 E., M.D.B.&M

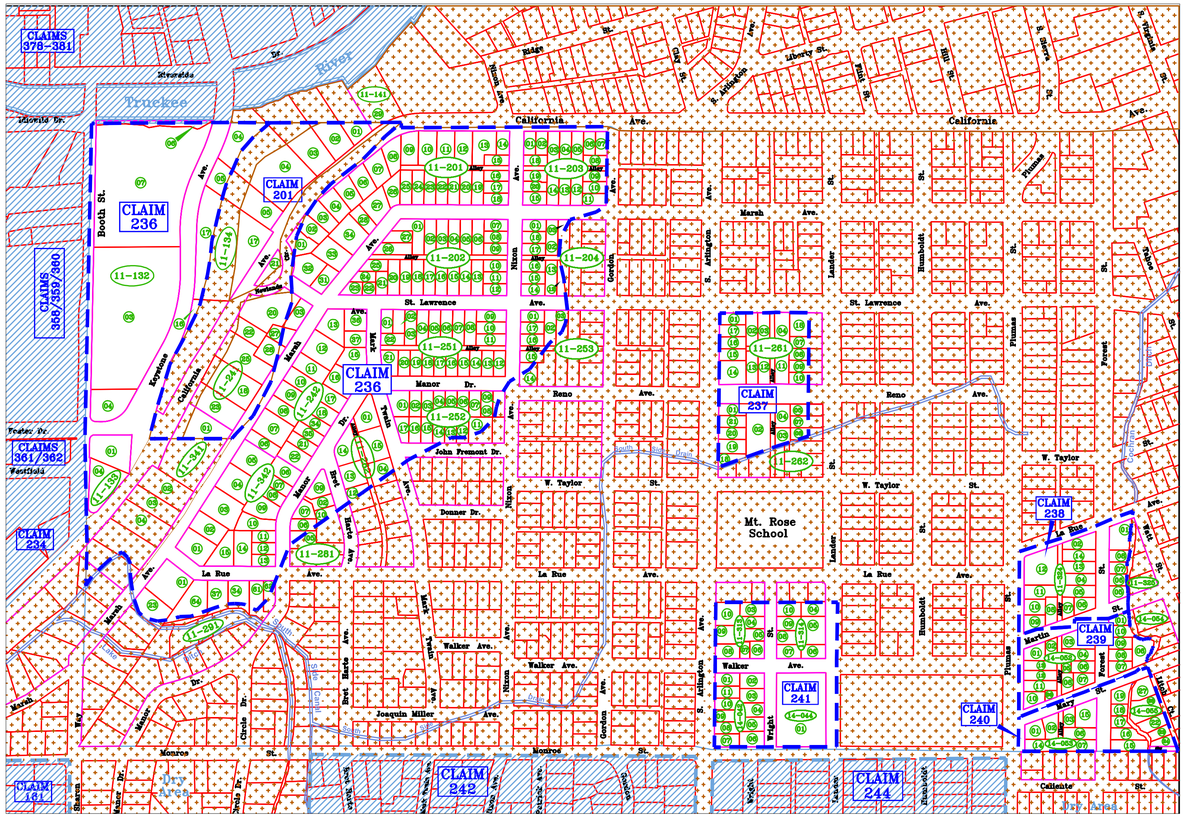

CLAIM 201

PARCEL	AREA
11-134-01	0.18
11-134-02	0.37
11-134-03	0.47
11-134-04	0.99
11-134-05	0.40
11-134-17	0.64
11-141-29	0.03
11-241-18	0.57
11-241-20	0.57
11-241-21	0.12
11-241-22	0.20
11-241-23	0.45
11-241-25	0.50
11-241-27	0.08
11-241-28	0.19
11-341-01	0.37
California Ave.	0.86
Marsh Ave.	0.21
Total	7.00 Ac.

CLAIM 237

PARCEL	AREA
11-261 Alley	0.16
11-261-01	0.13
11-261-02	0.16
11-261-03	0.16
11-261-04	0.22
11-261-07	0.09
11-261-08	0.09
11-261-09	0.09
11-261-10	0.09
11-261-11	0.20
11-261-12	0.16
11-261-13	0.16
11-261-14	0.26
11-261-15	0.13
11-261-16	0.13
11-261-17	0.13
11-261-18	0.16
11-262 Alley	0.08
11-262-01	0.13
11-262-02	0.50
11-262-03	0.11
11-262-04	0.14
11-262-05	0.09
11-262-07	0.09
11-262-08	0.08
11-262-18	0.12
11-262-19	0.16
11-262-20	0.13
11-262-21	0.13
Reno Ave.	0.68
Total	5.00 Ac.

CLAIM 238

PARCEL	AREA
11-324 Alley	0.15
11-324-02	0.16
11-324-04	0.16
11-324-05	0.16
11-324-06	0.13
11-324-07	0.10
11-324-08	0.13
11-324-09	0.13
11-324-10	0.14
11-324-11	0.20
11-324-12	0.45
11-324-13	0.16
11-324-14	0.16
11-325-01	0.23
11-325-05	0.10
11-325-06	0.09
11-325-07	0.08
11-325-08	0.09
Forest St.	0.42
La Rue Ave.	0.26
Martin St.	0.33
Plumas St.	0.17
Total	4.00 Ac.

CLAIM 239

PARCEL	AREA
14-052 Alley	0.11
14-052-01	0.13
14-052-02	0.10
14-052-03	0.26
14-052-04	0.16
14-052-05	0.05
14-052-06	0.11
14-052-07	0.12
14-052-08	0.10
14-052-09	0.04
14-052-10	0.12
14-052-11	0.14
14-052-12	0.13
14-052-13	0.13
14-054-01	0.09
14-054-06	0.20
14-054-07	0.12
14-054-08	0.11
14-054-09	0.11
14-054-10	0.12
Forest St.	0.32
Martin St.	0.31
Mary St.	0.26
Plumas St.	0.16
Total	3.50 Ac.

CLAIM 240

PARCEL	AREA
14-053 Alley	0.08
14-053-01	0.14
14-053-02	0.14
14-053-03	0.09
14-053-06	0.16
14-053-07	0.16
14-053-14	0.16
14-053-15	0.22
14-055-15	0.17
14-055-16	0.14
14-055-17	0.09
14-055-18	0.08
14-055-19	0.13
14-055-22	~~0.22~~ 0.13 MR 5 DEC 05
14-055-23	~~0.17~~ 0.09 MR 5 DEC 05
14-055-24	~~0.14~~ 0.08
14-055-27	~~0.09~~ 0.17
14-055-28	~~0.06~~ 0.26
14-055-Alley	~~0.18~~ 0.05
Forest St.	0.34
Plumas St.	0.09
Mary St.	0.48
Total	3.50 Ac.
Litch Ct.	0.09 MR 5 DEC 05

CLAIM 241

PARCEL	AREA
11-313-03	0.14
11-313-04	0.12
11-313-05	0.13
11-313-06	0.10
11-313-07	0.07
11-313-08	0.14
11-313-09	0.20
11-313-10	0.22
11-314-04	0.14
11-314-05	0.28
11-314-06	0.14
11-314-07	0.14
11-314-08	0.14
11-314-09	0.14
11-314-10	0.14
14-042-01	0.13
14-042-02	0.15
14-042-03	0.14
14-042-04	0.14
14-042-05	0.14
14-042-06	0.16
14-042-07	0.13
14-042-08	0.12
14-042-09	0.12
14-042-10	0.12
14-042-11	0.12
14-044-01	1.47
Lander St.	0.66
Walker Ave.	0.56
Wright St.	0.70
Total	7.10 Ac.

CLAIM 236

PARCEL	AREA
11-132-03	4.93
11-132-04	0.47
11-132-06	0.12
11-132-07	4.70
11-133-01	0.50
11-133-04	0.50
11-134-04	0.47
11-134-05	0.32
11-134-16	0.09
11-134-17	0.68
11-201 Alley	0.21
11-201-01	0.16
11-201-02	0.20
11-201-03	0.20
11-201-04	0.23
11-201-05	0.22
11-201-06	0.22
11-201-07	0.25
11-201-08	0.23
11-201-09	0.23
11-201-10	0.25
11-201-11	0.25
11-201-12	0.25
11-201-13	0.28
11-201-14	0.13
11-201-15	0.11
11-201-16	0.11
11-201-17	0.12
11-201-18	0.12
11-201-19	0.17
11-201-20	0.17
11-201-21	0.17
11-201-22	0.17
11-201-23	0.17
11-201-24	0.17
11-201-25	0.17
11-201-26	0.18
11-201-27	0.26
11-201-28	0.15
11-201-31	0.17
11-201-32	0.29
11-201-33	0.28
11-201-34	0.37
11-202 Alley	0.27
11-202-01	0.25
11-202-02	0.17
11-202-03	0.17
11-202-04	0.17
11-202-05	0.17
11-202-06	0.17
11-202-07	0.11
11-202-08	0.11
11-202-09	0.11
11-202-10	0.11
11-202-11	0.11
11-202-12	0.11
11-202-13	0.17
11-202-14	0.17
11-202-15	0.17
11-202-16	0.17
11-202-17	0.17
11-202-18	0.17
11-202-19	0.17
11-202-20	0.17
11-202-21	0.11
11-202-22	0.07
11-202-23	0.10
11-202-24	0.10
11-202-25	0.12
11-202-26	0.17
11-202-27	0.13
11-203 Alley	0.16
11-203-01	0.11
11-203-02	0.11
11-203-03	0.17
11-203-04	0.17
11-203-05	0.17
11-203-06	0.11
11-203-07	0.11
11-203-08	0.10
11-203-09	0.10
11-203-10	0.10
11-203-11	0.10
11-203-12	0.17
11-203-13	0.17
11-203-14	0.17
11-203-15	0.13
11-203-16	0.10
11-203-19	0.11
11-203-20	0.10
11-204 Alley	0.07
11-204-01	0.11
11-204-02	0.17
11-204-03	0.08
11-204-12	0.09
11-204-13	0.17
11-204-14	0.11
11-204-15	0.11
11-204-16	0.11
11-204-17	0.11
11-204-18	0.11
11-241-03	0.18
11-241-20	0.05
11-241-27	0.07
11-241-28	0.03
11-242-06	0.17
11-242-07	0.38
11-242-08	0.22
11-242-09	0.26
11-242-10	0.23
11-242-11	0.24
11-242-12	0.38
11-242-13	0.30
11-242-15	0.24
11-242-16	0.27
11-242-17	0.20
11-242-18	0.19
11-242-21	0.14
11-242-22	0.22
11-242-34	0.17
11-242-35	0.14
11-242-36	0.19
11-242-37	0.14
11-251 Alley	0.24
11-251-01	0.11
11-251-02	0.11
11-251-03	0.17
11-251-04	0.17
11-251-05	0.17
11-251-06	0.17
11-251-07	0.17
11-251-08	0.17
11-251-09	0.14
11-251-10	0.14
11-251-11	0.14
11-251-12	0.13
11-251-13	0.13
11-251-14	0.13
11-251-15	0.13
11-251-16	0.13
11-251-17	0.13
11-251-18	0.13
11-251-19	0.13
11-251-20	0.13
11-251-21	0.17
11-251-22	0.11
11-252-01	0.21
11-252-02	0.13
11-252-03	0.13
11-252-04	0.13
11-252-05	0.13
11-252-06	0.13
11-252-07	0.13
11-252-08	0.13
11-252-09	0.06
11-252-11	0.13
11-252-12	0.10
11-252-13	0.10
11-252-14	0.12
11-252-15	0.13
11-252-16	0.13
11-252-17	0.12
11-253 Alley	0.06
11-253-01	0.11
11-253-02	0.17
11-253-03	0.09
11-253-14	0.05
11-253-15	0.11
11-253-16	0.11
11-253-17	0.11
11-261-02	0.12
11-281-05	0.05
11-281-06	0.12
11-281-07	0.12
11-281-09	0.19
11-281-10	0.09
11-282 Alley	0.14
11-282-01	0.26
11-282-04	0.18
11-282-12	0.09
11-282-13	0.23
11-282-14	0.27
11-282-15	0.32
11-291-01	0.51
11-291-23	0.30
11-291-34	0.20
11-291-37	0.22
11-291-51	0.16
11-291-52	0.06
11-291-54	0.37
11-342-01	0.36
11-342-02	0.28
11-342-03	0.41
11-342-04	0.40
11-342-05	0.40
11-342-06	0.22
11-342-07	0.14
11-342-08	0.15
11-342-09	0.28
11-342-10	0.20
11-342-11	0.11
11-342-12	0.11
11-342-13	0.11
11-342-14	0.26
11-342-15	0.30
Booth St.	0.73
Bret Harte Ave.	0.41
California Ave.	0.52
Foster Dr.	0.27
John Fremont Dr.	0.16
Keystone Ave.	2.44
La Rue Ave.	0.64
Manor Dr.	1.81
Mark Twain Ave.	0.97
Marsh Ave.	3.25
Nixon Ave.	1.44
St. Lawrence Ave.	1.45
Total	59.00 Ac.

This map is solely for the purpose of describing acreage to which water rights were allocated by the final decree in the United States vs. Orr Water Ditch Company, in Equity, Docket No. A3 and for no other purpose. The map is based upon the State Engineer's and the Federal Water Master's interpretation of the final decree using information available in the State Engineer's and the Federal Water Master's office as of the date of this approval. This map should not be relied upon as a legal description of any specific parcel.

APPROVED BY THE STATE ENGINEER:

s/Hugh Ricci, P.E. 11/14/05
Hugh Ricci, P.E. Date

APPROVED BY THE FEDERAL WATER MASTER:

s/Garry D. Stone 11/18/05
Garry D. Stone Date

PORTIONS OF SECTIONS COVERED BY THIS MAP

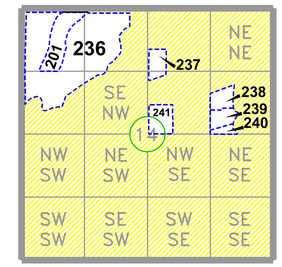

Claim on Lake Ditch water–201

Transfers to Lake Ditch Water from South Side Canal via Permit 11489–Claims 236-241. Only points of diversion were changed.

LEGEND

- lot/parcel line
- block boundary
- section / 1/4 section } Public Land Survey System (PLSS) lines
- creek/ditch
- area covered by decreed water rights
- dry area not containing decreed water rights
- claim coverage on other map
- 99–999 Washoe County Assessor's parcel number (APN): block, page, book
- 99 lot number
- Section corner
- found quarter corner or center section marker

300 0 150 300 600 ft.
SCALE

REVISIONS			
	DATE	BY	NOTES
1			
2			
3			
4			

CHECKED BY	
DEPUTY STATE ENGINEER	TWT
PROJECT SUPERVISOR	RHZ / MJR
F.W.M. OFFICE REVIEWER	JMP

STATE of NEVADA
Division of Water Resources
123 W. Nye Ln., Carson City NV 89710

DRAWING NO.: TR-083
DRAWN BY: P. Mohn / M. Randall Date: 11/10/2005