STATE OF NEVADA
DIVISION OF WATER RESOURCES
WELL DRILLER'S PLUGGING REPORT

OFFICE USE ONLY
Log No 101118
Permit No
Basin 104

PRINT OR TYPE ONLY
DO NOT WRITE ON BACK

Please complete this form in its entirety in accordance with NRS 534.170 and NAC 534.340

NOTICE OF INTENT NO

1. OWNER Bill Abdul
MAILING ADDRESS 3387 Hwy 50 E
Carson City, NV 89701

ADDRESS AT WELL LOCATION 3389 Hwy 50 E
Carson City, NV 89701

2. LOCATION NE¼ SW ¼ Sec 10 T 15 N/S R 20 E
PERMIT/WAIVER No 008-303-12 (Issued by Water Resources) Parcel No.

Latitude
Longitude
Subdivision Name
UTM E
N
☐ NAD 27 ☐ NAD 83/WGS 84
County

3. TYPE OF WELL
☐ Domestic ☐ Irrigation ☐ Test
☐ Municipal/Industrial XX Monitor ☐ Stock

Is this well being plugged because a replacement well was drilled? no
If yes, what is replacement well NO?

Is there an existing well log?
If yes, what is NDWR well log #?

4. EXISTING WELL CONSTRUCTION
Depth Drilled 15 Feet Depth Cased 5-15 Feet

EXISTING CASING SCHEDULE

Size O.D. (Inches)	Weight/Ft. (Pounds)	Wall Thickness (Inches)	From (Feet)	To (Feet)
4"			5	15

Existing Perforations:
Type of perforation machine slot
Size of perforation .020
From 5 feet to 15 feet
From feet to feet
From feet to feet
From feet to feet
From feet to feet

5. WATER LEVEL
Static water level N/A feet below land surface
Artesian flow N/A G.P.M. P.S.I.
Water temperature °F Quality

6. Additional Notes or Comments

Backfill with neat cement, drill out top 5'

MW-3

7. WELL PLUGGING PROCEDURE
Was well cleaned out to total depth? XX yes ☐ no
If well was not cleaned out to total depth, please explain why

Was the well contaminated? ☐ yes XX no
Was the casing pulled? ☐ yes XX no
Was the casing over drilled? ☐ yes ☐ no
If casing was left in place, please show where additional perforations were made:
Additional Perforations:
Type of perforator used N/A
From feet to feet Number of perfs per linear foot
From feet to feet Number of perfs per linear foot
8. WELL PLUGGING MATERIALS

From	feet to	feet	Material Used		
0	15		neat	XX Pumped	☐ Poured
			cement	☐ Pumped	☐ Poured
				☐ Pumped	☐ Poured
				☐ Pumped	☐ Poured
				☐ Pumped	☐ Poured
				☐ Pumped	☐ Poured

Neat Cement Fluid Weight 9.4 lbs/gal
Bentonite Grout % bentonite
Date Started 4-3-06
Date Completed 4-4-06

9. DRILLER'S CERTIFICATION
This well was plugged and abandoned under my supervision and the report is true to the best of my knowledge.
Name Western Strata (Contractor)
Address P O Box 657 (Contractor)
Clarksburg, CA 95612
Nevada contractor's license number issued by the State Contractor's Board 0033695A
Nevada driller's license number issued by the Division of Water Resources, the on-site driller M-1978
Signed (By driller performing actual drilling on the or contractor)
Date 4-5-06

USE ADDITIONAL SHEETS IF NECESSARY

03/29/2006 16:55 MCGINLEY ASSOCIATES → 19167441453 NO.715 D02

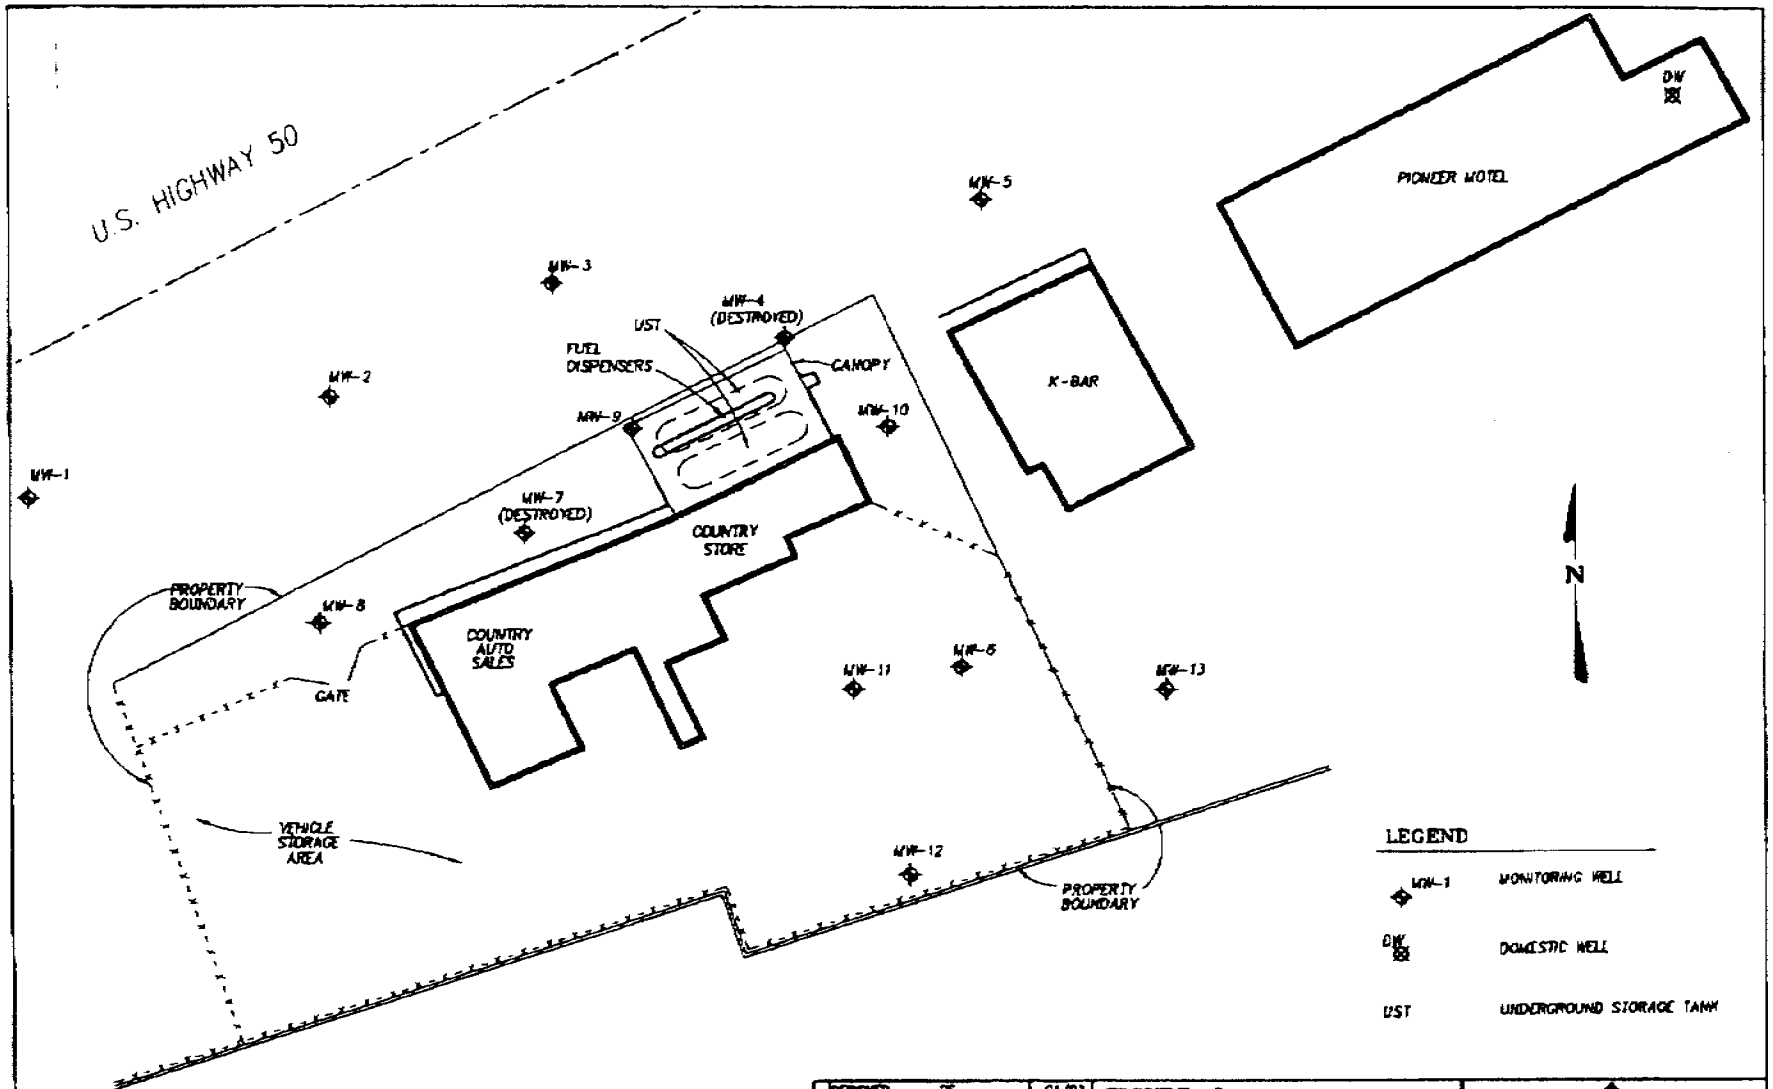

DESIGNED	DE	01/03	
DRAWN	TAD	01/03	
CHECKED			
APPROVED			
No.	DESCRIPTION	BY	DATE

FIGURE 2

SITE PLAN
-EXISTING-
GROUNDWATER MONITORING WELLS
COUNTRY STORE
3389 HIGHWAY 50
CARSON CITY, NEVADA

McGinley & Associates

SCALE: AS SHOWN
JOB NO. ABD-001
DWG NAME ABD-001-02-JAN-03
REVISION A

Z:\Projects\Drafting\ABD-001\DWG\ABD-001-JAN-02.dwg 03/24/05 16:40 TAD

10118