S05146

WHITE—DIVISION OF WATER RESOURCES
CANARY—CLIENT'S COPY
PINK—WELL DRILLER'S COPY

PRINT OR TYPE ONLY
DO NOT WRITE ON BACK

STATE OF NEVADA
DIVISION OF WATER RESOURCES

WELL DRILLER'S REPORT

Please complete this form in its entirety in accordance with NRS 534.170 and NAC 534.340

I

OFFICE USE ONLY
Log No. 101237
Permit No.
Basin Ø90

NOTICE OF INTENT NO. ~~52397~~ 52383 - MMH 8/23/1

1. OWNER Chevron
MAILING ADDRESS 899 Tahoe Blvd Incline Village, NV
ADDRESS AT WELL LOCATION 899 Tahoe Blvd. Incline Village, Nevada

2. LOCATION NE ¼ SW ¼ Sec. 15 T. 16 N/S R. 18 E. Washoe County
PERMIT NO. M/o-1055 (Issued by Water Resources) ~~13222061~~ (Parcel No.) 13224010 (Subdivision Name)

3. WORK PERFORMED
☐ New Well ☐ Replace ☐ Recondition
☐ Deepen ☑ Abandon ☐ Other

4. PROPOSED USE
☐ Domestic ☐ Irrigation ☐ Test
☐ Municipal/Industrial ☑ Monitor ☐ Stock

5. WELL TYPE
☐ Cable ☐ Rotary ☐ RVC
☐ Air ☑ Other

6. LITHOLOGIC LOG

Material	Water Strata	From	To	Thickness
Abandon 2" PVC MONITOR well. PR Grout neat cement to 1'. Concrete/Dirt seal surface to 1'				

RECEIVED 2006 JUL 25 PM 1:01 STATE ENGINEERS OFFICE

Date started 6-8-05, 20
Date complated 6-8-05, 20

7. WELL TEST DATA
TEST METHOD: ☐ Bailer ☐ Pump ☐ Air Lift

G.P.M.	Draw Down (Feet Below Static)	Time (Hours)

8. WELL CONSTRUCTION
Depth Drilled 100 Feet Depth Cased 100 Feet

HOLE DIAMETER (BIT SIZE)
From To
Inches Feet Feet
Inches Feet Feet
Inches Feet Feet

CASING SCHEDULE

Size O.D. (Inches)	Weight/Ft. (Pounds)	Wall Thickness (Inches)	From (Feet)	To (Feet)
2"		Sch40PVC	0	100

Perforations:
Type perforation
Size perforation
From feet to feet
From feet to feet
From feet to feet
From feet to feet
From feet to feet

Surface Seal: ☑ Yes ☐ No
Depth of Seal
Placement Method: ☑ Pumped ☐ Poured
Seal Type: ☑ Neat Cement ☐ Cement Grout ☐ Concrete Grout

Gravel Packed: ☐ Yes ☐ No
From feet to feet

9. WATER LEVEL
Static water level feet below land surface
Artesian flow G.P.M. P.S.I.
Water temperature °F Quality

10. DRILLER'S CERTIFICATION
This well was drilled under my supervision and the report is true to the best of my knowledge.
Name Cascade Drilling, Inc. (Contractor)
Address 3632 Omec Circle (Contractor) Rancho Cordova, CA 95742
Nevada contractor's license number issued by the State Contractor's Board C23-51207
Nevada driller's license number issued by the Division of Water Resources, the on-site driller M-1724
Signed Alfa Bally (By driller performing actual drilling on site or contractor)
Date November 11, 2005

(Rev. 12-01) USE ADDITIONAL SHEETS IF NECESSARY (O)-627

101237

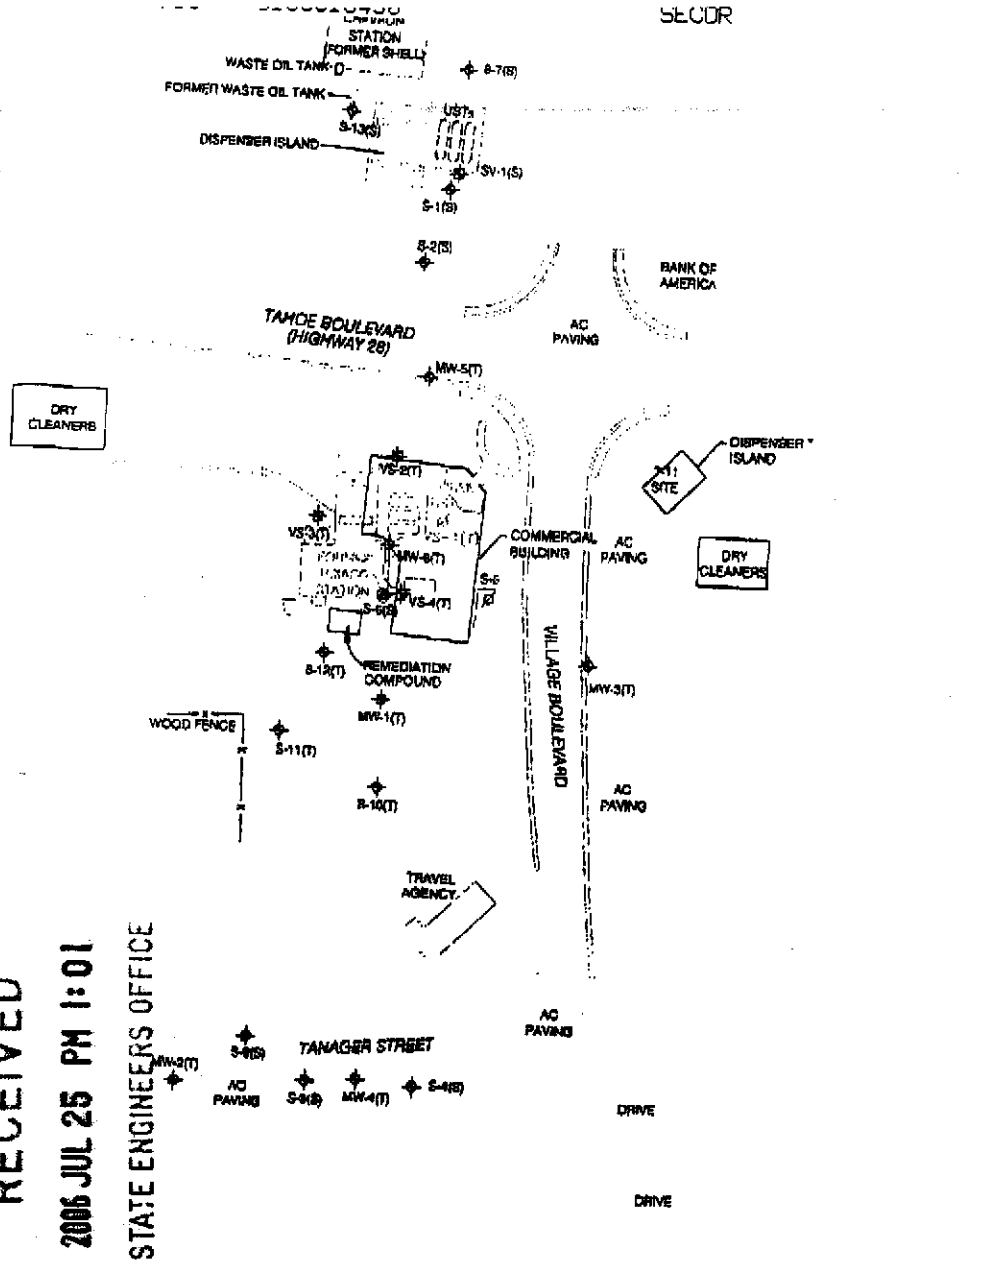

RECEIVED
2006 JUL 25 PM 1:01
STATE ENGINEERS OFFICE

LEGEND:

- GROUNDWATER MONITORING WELL (T) TEXACO (S) SHELL
- VAPOR EXTRACTION WELL (T) TEXACO (S) SHELL
- GROUNDWATER EXTRACTION WELL (T) TEXACO (S) SHELL
- S-5 ABANDONED WELL
- VS-1(T) DESTROYED VAPOR EXTRACTION WELL (T) TEXACO
- LOCATION IS APPROXIMATE AND IS FOR REFERENCE ONLY.

NOTE: VS-4 & MW-6 HAVE BEEN MODIFIED AND THEIR LOCATIONS ARE APPROXIMATE.

S-8(S) INCLINE WAY

N

REFERENCE: THIS FIGURE IS BASED ON SURVEY DATA PROVIDED BY MORROW SURVEYING.

0 80 160
SCALE IN FEET

SECOR 2017 WILDER ROAD, SUITE 100 RANCHO CORDOVA, CALIFORNIA PHONE: (916) 851-0400/987-0289 (FAX)	FOR: FORMER TEXACO SERVICE STATION 21-1486 669 TAHOE BOULEVARD INCLINE VILLAGE, NEVADA	SITE PLAN		FIGURE: 2
	JOB NUMBER: 77CH.21486.01.0570	DRAWN BY: RT	CHECKED BY: BJ	APPROVED BY: DJ	DATE: 01/21/06

CHEVRON21 14MICH-21486 SITEPLAN.AWL 4/19/2003 9:59:02 AM, 6Vy, SACRAMENTO, 97