WHITE—DIVISION OF WATER RESOURCES
CANARY—CLIENT'S COPY
PINK—WELL DRILLER'S COPY
NDEP#4-000061
PRINT OR TYPE ONLY
DO NOT WRITE ON BACK

STATE OF NEVADA
DIVISION OF WATER RESOURCES

WELL DRILLER'S REPORT

Please complete this form in its entirety in accordance with NRS 534.170 and NAC 534.340

OFFICE USE ONLY
Log No. 109731
Permit No.
Basin 1090 pg 1 of 3

NOTICE OF INTENT NO. 60453

1. OWNER Chevron Environmental Mng. Co
MAILING ADDRESS 6001 Bollinger Cyn Rd
San Ramon, CA 94583

ADDRESS AT WELL LOCATION 947 Tahoe Blvd.
Incline Village, NV 89451
N: 1476764 9.36 E: 2239011.49 NAD 83

2. LOCATION NW 1/4 NE 1/4 Sec. 15 T. 16 N S R. 18 E. Washoe County
PERMIT NO. NDEP #4-000061 Issued by Water Resources
132-231-10 Parcel No.
Incline Village Subdivision Name

3. WORK PERFORMED
☑ New Well ☐ Replace ☐ Recondition
☐ Deepen ☐ Abandon ☐ Other

4. PROPOSED USE Air Sparge
☐ Domestic ☐ Irrigation ☐ Test
☐ Municipal/Industrial ☑ Monitor ☐ Stock

5. WELL TYPE
☐ Cable ☐ Rotary ☐ RVC
☐ Air ☑ Other Sonic

6. LITHOLOGIC LOG

Material	Water Strata	From	To	Thickness
Lt brn Sand & Cobbles		0	10	10
brn silty sand some Gravel		10	15	5
Greish brn Sandy slt & gravel fine to coarse	>	15	21	6
Lt br Greyish silty sand, Trace CL		21	28	7
brn Sand w/slt moist		28	31	3
Greyish brn sand wet	31	31	33	2
brnish grey silty cly		33	35	2
grey sand w/silt		35	38	3
Greyish brn silt w/CL		38	44	6
39.258603°N				
119.944360°W NAD27 (TM)				
well #				
AS-2				
~~Grey No~~				
~~N 39.2489164~~				
~~W 119.9389164 NAD27~~				

Date started 7-21, 2007
Date completed 7-21, 2007

7. WELL TEST DATA
TEST METHOD: ☐ Bailer ☑ Pump ☐ Air Lift

G.P.M.	Draw Down (Feet Below Static)	Time (Hours)
	32' 3"	1 hr

8. WELL CONSTRUCTION
Depth Drilled 47 Feet Depth Cased 46 Feet

HOLE DIAMETER (BIT SIZE)

	Inches	From (Feet)	To (Feet)
	6"	0	47

CASING SCHEDULE

Size O.D. (Inches)	Weight/Ft. (Pounds)	Wall Thickness (Inches)	From (Feet)	To (Feet)
2 3/8	Sch 80		0	46

Perforations:
Type perforation Slotted
Size perforation .020
From 45 feet to 46 feet
From feet to feet
From feet to feet
From feet to feet
From feet to feet

Surface Seal: ☑ Yes ☐ No
Depth of Seal 1'-42' cement 42-44 med chips
Placement Method: ☐ Pumped ☑ Poured
Seal Type: ☐ Neat Cement ☑ Cement Grout ☐ Concrete Grout

Gravel Packed: ☑ Yes ☐ No
From 44 feet to 46-0 feet

9. WATER LEVEL
Static water level 31' 8" feet below land surface
Artesian flow — G.P.M. — P.S.I.
Water temperature C °F Quality

10. DRILLER'S CERTIFICATION
This well was drilled under my supervision and the report is true to the best of my knowledge.
Name Mario Romero / Prosonic Contractor
Address 12464 Mc Cann Dr Contractor
Santa fe Springs CA 90670
Nevada contractor's license number issued by the State Contractor's Board 0051765
Nevada driller's license number issued by the Division of Water Resources, the on-site driller M-2313
Signed By driller performing actual drilling on site or contractor
Date 8-23-07

RECEIVED 2008 JUL 10 AM 10:15 STATE ENGINEERS OFFICE
RECEIVED 2007 OCT -1 AM 10:12 STATE ENGINEERS OFFICE

(Rev. 12-01) USE ADDITIONAL SHEETS IF NECESSARY (O)-627

Map of Site:

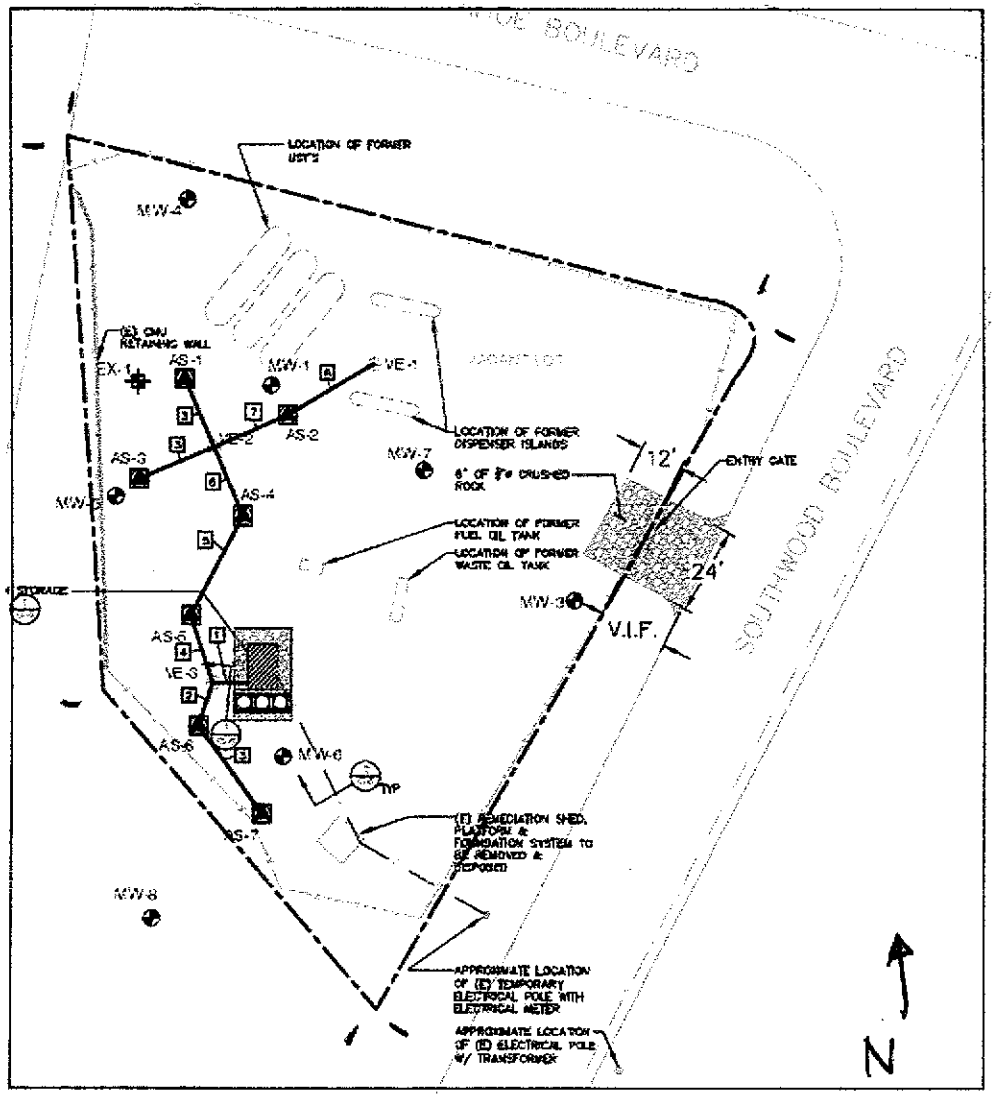

RECEIVED
2007 OCT -1 AM 10: 12
STATE ENGINEERS OFFICE

RECEIVED
2008 JUL 10 AM 10: 15
STATE ENGINEERS OFFICE

Log # 109731
Pg 2 of 3

Log # 109731 pg 3 of 3

SECOR

JOB NAME _____
JOB NO. _____
CALCULATED BY _____ DATE _____
CHECKED BY _____ DATE _____
SHEET _____ OF _____

Scale: 1" = 20'

USE 20 scale on engineering sheet

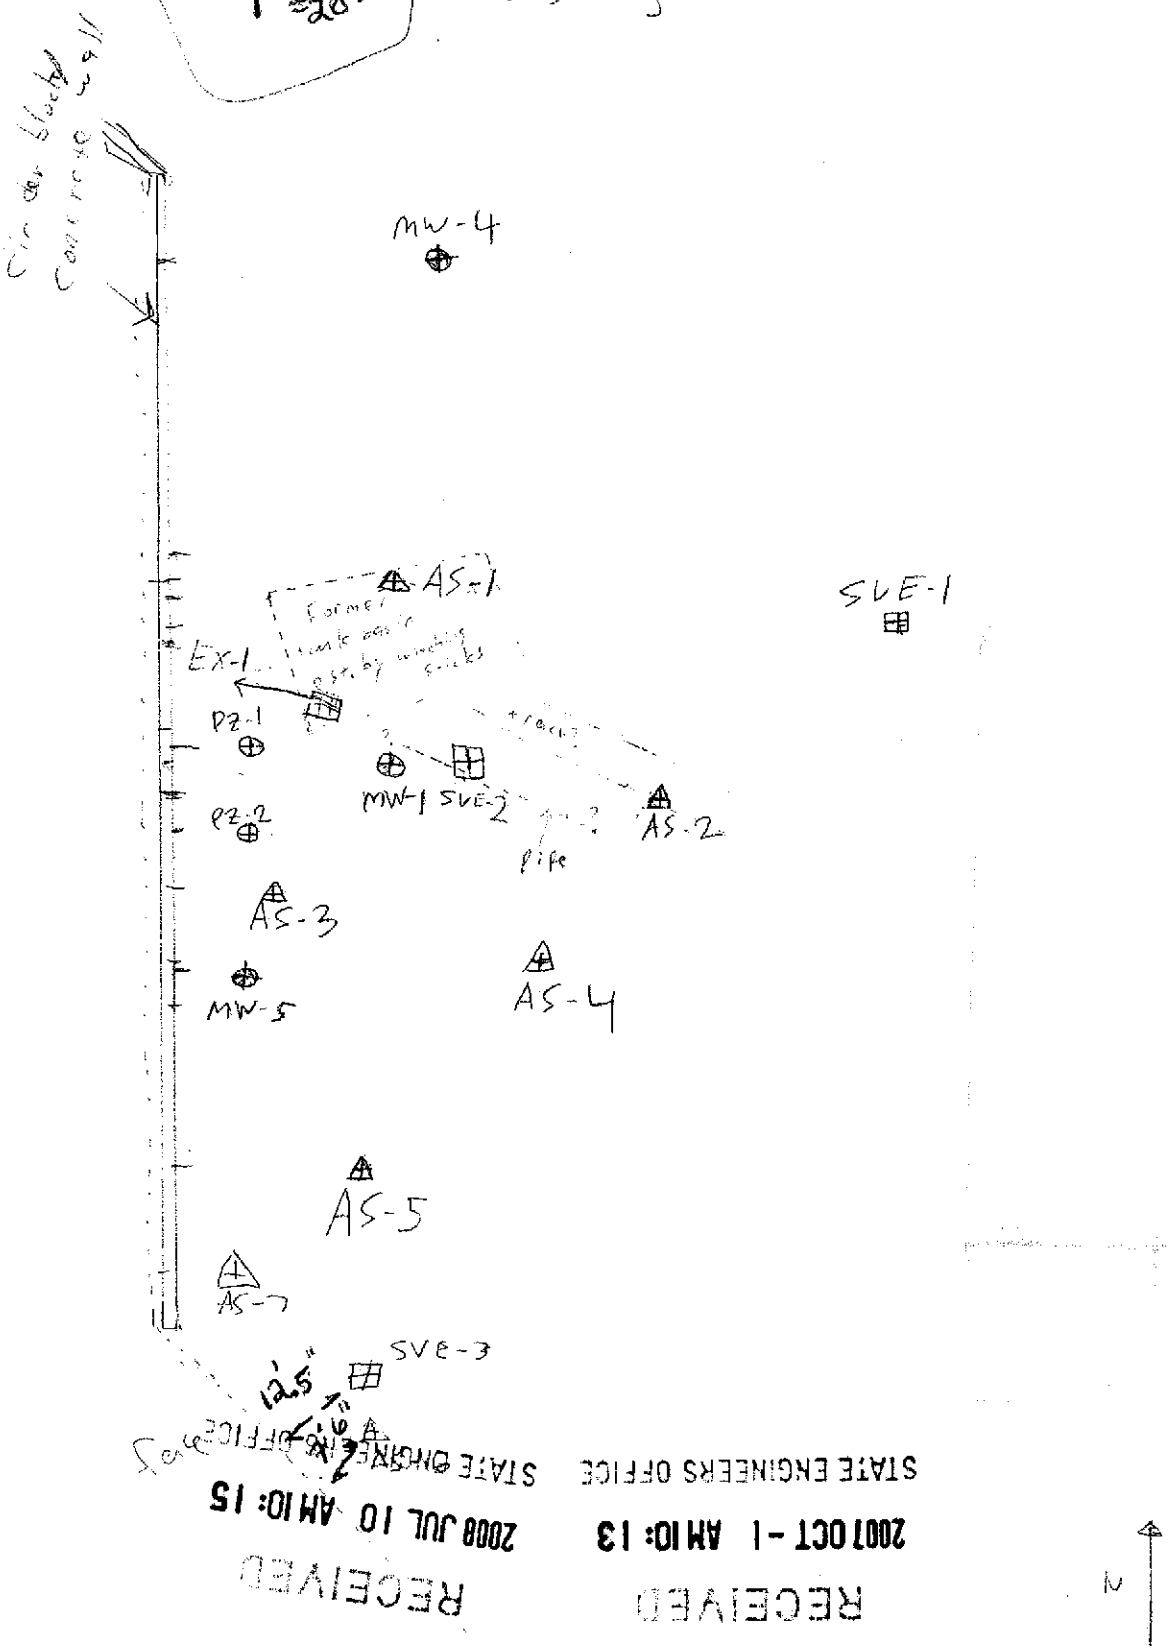

RECEIVED
2007 OCT -1 AM 10: 13
STATE ENGINEERS OFFICE
RECEIVED
2008 JUL 10 AM 10: 15
STATE ENGINEERS OFFICE