WESTERN TECHNOLOGIES INC.

4085 Nevso Drive, Suite G
Las Vegas, Nevada 89103
(702) 252-0580

October 22, 1990

Nevada Division of Water Resources
Capital Complex
123 West Nye Lane
Carson City, Nevada 89710

Attention: Mr. Thomas K. Gallagher, P.E.

Project No. 4170K009

Reference: Completion Report
Waiver M/O - 301
Northeast Corner Bonanza Road and "D" Street
Las Vegas, Nevada

Dear Mr. Gallagher,

Western Technologies, Inc. (WT) has constructed the three monitoring wells at the Marcor Resorts property (future Valley Foods Warehouse) located on the northeast corner of Bonanza Road and "D" Street in Las Vegas, Nevada. Per your letter dated September 18, 1990, the Well Driller's Report forms and a site plan of the property showing well locations are attached. The wells will be monitored for a period of six months then plugged and abandoned according to the requirements.

If you have any questions or require additional information please contact this office.

Sincerely,

WESTERN TECHNOLOGIES, INC.

Timothy P. Aten

TIMOTHY P. ATEN
Project Manager

RECEIVED
OCT 26 1990
Div. of Water Resources
Branch Office - Las Vegas, NV

WILLIAM C. YECKES, P.G., R.E.A.
Director of
Environmental Services

\khw

pc: Marcor

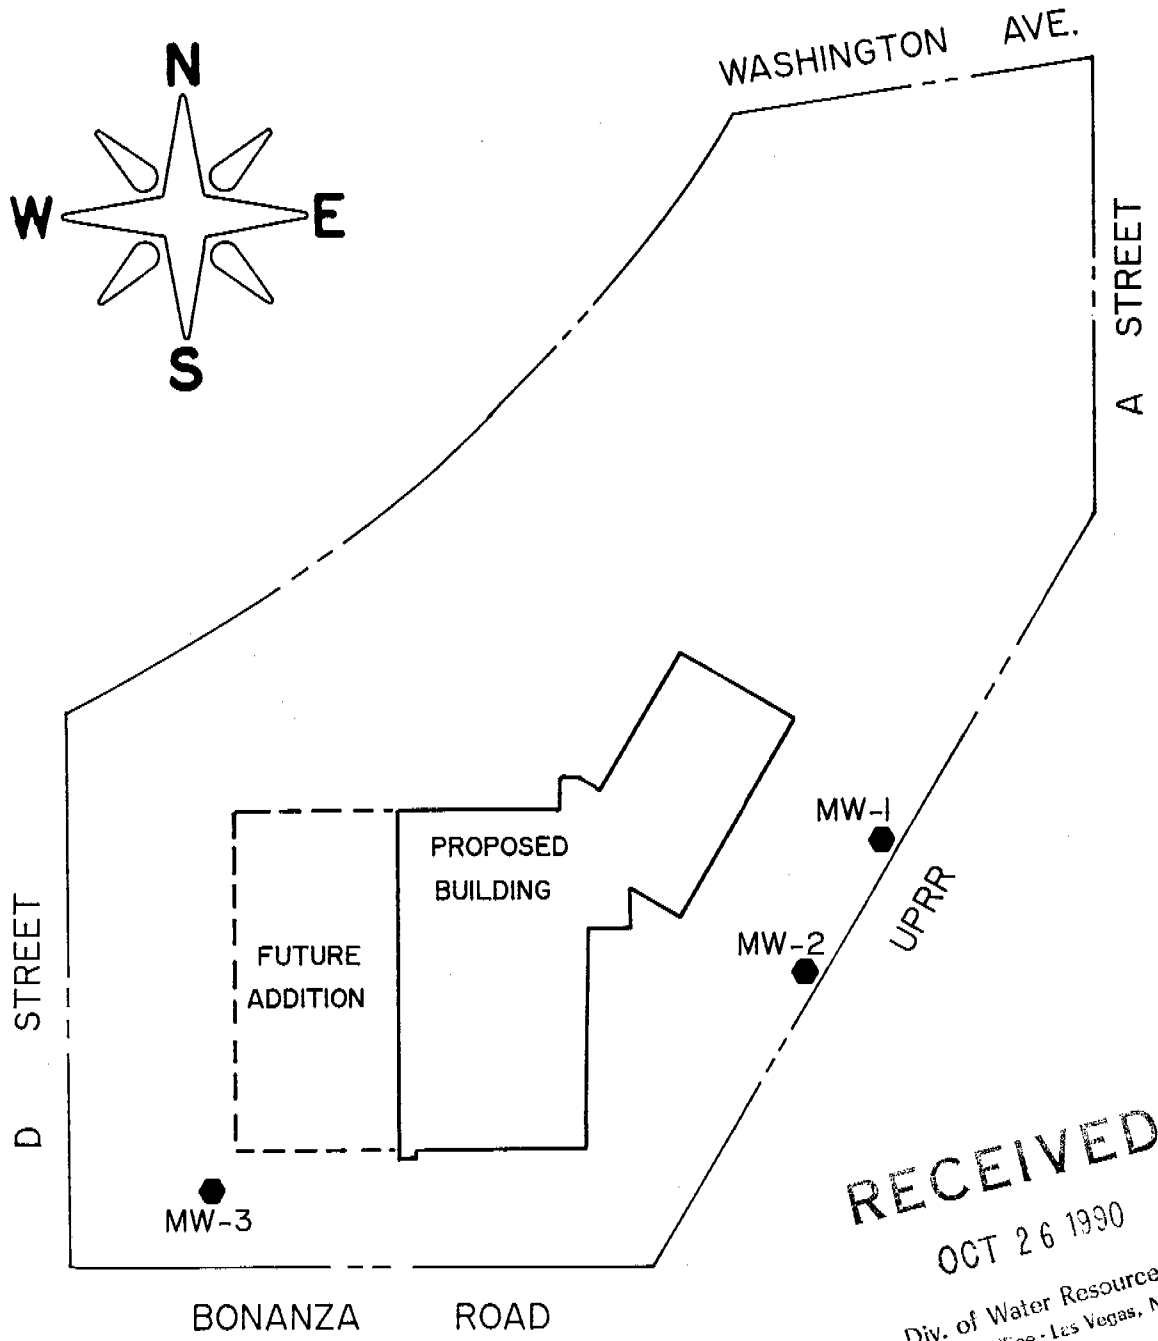

RECEIVED
OCT 26 1990
Div. of Water Resources
Branch Office - Las Vegas, NV

KEY:

● – MONITORING WELL LOCATION

SCALE: 1" = 200'

WESTERN TECHNOLOGIES INC.		SITE PLAN	
BY: TPA	DATE: 10/02/90	PROJECT NO.: 4170K009	PLATE: 1

WESTERN TECHNOLOGIES INC.

4085 Nevso Drive, Suite G
Las Vegas, Nevada 89103
(702) 252-0580

B (WAIVER No)

February 27, 1991

State of Nevada
Division of Water Resources
123 W. Nye Lane
Carson City, Nevada 89710

Attention: State Engineer

Reference: Groundwater Monitoring Well Closure
35 W. Owens Ave.
Las Vegas, Nevada

Dear Sir:

Western Technologies Inc. (WT) is pleased to provide this letter which presents the closure of the three monitoring wells located at the above referenced site. The wells are owned by Southwest Gas Corporation and are located in Section 27, Township 20 South, Range 61 East in the city of Las Vegas, Nevada. Prior to removal, the wells were in good condition and were used as active monitoring wells for environmental purposes.

The wells were plugged on February 5, 1991 using the following methods:

- As stated in Section 534.420 of the Regulations for Water Well and Related Drilling, the well casing was "ripped" to allow the plugging fluid to penetrate the area between the casing and the wall of the drill hole.

- The well was then plugged with neat cement as described in Section 534.420 of the Regulations for Water Well and Related Drilling.

If you have any questions regarding this matter, please do not hesitate to contact this office.

Sincerely,

WESTERN TECHNOLOGIES INC.

Roy D. Jackson

ROY D. JACKSON
Licensed Driller
License No. M1598

Robert M. Huskey

ROBERT M. HUSKEY
Assistant Director
Environmental Services

/kkp