WHITE--DIVISION OF WATER RESOURCES
CANARY--CLIENT'S COPY
PINK--WELL DRILLER'S COPY

PRINT OR TYPE ONLY
DO NOT WRITE ON BACK

STATE OF NEVADA
DIVISION OF WATER RESOURCES

WELL DRILLER'S REPORT

Please complete this form in its entirety in accordance with NRS 534.170 and NAC 534.340

OFFICE USE ONLY
Log No. 92449
Permit No.
Basin 53

NOTICE OF INTENT NO. ~~51829~~ 51820

1. OWNER Bac Tech Tonkin Springs
MAILING ADDRESS 249 3rd Street
Elko Nevada 89801
ADDRESS AT WELL LOCATION TSP1-03-TH1

2. LOCATION NE ¼ NE ¼ Sec. 3 T. 23½ N/S R. 49 E. Eureka County
PERMIT NO. 00-1302 Issued by Water Resources
Parcel No.
Subdivision Name

3. WORK PERFORMED
☒ New Well ☐ Replace ☐ Recondition
☐ Deepen ☐ Abandon ☐ Other

4. PROPOSED USE
☐ Domestic ☐ Irrigation ☐ Test
☐ Municipal/Industrial ☒ Monitor ☐ Stock

5. WELL TYPE
☐ Cable ☐ Rotary ☒ RVC
☐ Air ☐ Other

6. LITHOLOGIC LOG

Material	Water Strata	From	To	Thickness
Lime Stone		~~0~~	~~250'~~	~~250~~
"	Dry	0	130	130
"	17 gpm	130	250	120

Materials use:
For Surface Casing 4, 94 lbs Bags Nevada Cement
10' x 6 5/8" Casing 2, 50 lbs Bags W-60

44, 50 lbs Bags #8 Sand
13, 50 lbs Bags Mech. Hole Plug
8, 94 lbs Bags Nevada Cement for Surface Seal

Date started 11-11-03, 19
Date completed 11-11-03, 19

7. WELL TEST DATA
TEST METHOD: ☐ Bailer ☐ Pump ☐ Air Lift

G.P.M.	Draw Down (Feet Below Static)	Time (Hours)

8. WELL CONSTRUCTION
Depth Drilled 250 Feet Depth Cased 248 Feet

HOLE DIAMETER (BIT SIZE)

		From	To
10" Inches		0 Feet	10' Feet
6" Inches		10' Feet	250 Feet
Inches		Feet	Feet

CASING SCHEDULE

Size O.D. (Inches)	Weight/Ft. (Pounds)	Wall Thickness (Inches)	From (Feet)	To (Feet)
2"		Sch 80	+2	118

Perforations:
Type perforation .020 Horizontal Slot
Size perforation .020
From 118 feet to 248 feet
From feet to feet
From feet to feet
From feet to feet
From feet to feet

Surface Seal: ☒ Yes ☐ No
Depth of Seal 50
Placement Method: ☐ Pumped ☒ Poured
Seal Type: ☒ Neat Cement ☐ Cement Grout ☐ Concrete Grout

Gravel Packed: ☒ Yes ☐ No
From 50 feet to 250 feet

9. WATER LEVEL
Static water level 130' feet below land surface
Artesian flow NA G.P.M. P.S.I.
Water temperature Cool °F Quality 17 gpm

10. DRILLER'S CERTIFICATION
This well was drilled under my supervision and the report is true to the best of my knowledge.
Name Eklund Drilling Contractor
Address PO Box 2748 Contractor
Elko, Nevada 89803
Nevada contractor's license number issued by the State Contractor's Board 0030823
Nevada driller's license number issued by the Division of Water Resources, the on-site driller M-2100
Signed [signature] By driller performing actual drilling on site or contractor
Date 11-11-03

(Rev. 3-91) USE ADDITIONAL SHEETS IF NECESSARY (O)-627

Plugged by well log 124239

Drill Hole ID

TSP1-03-TH1

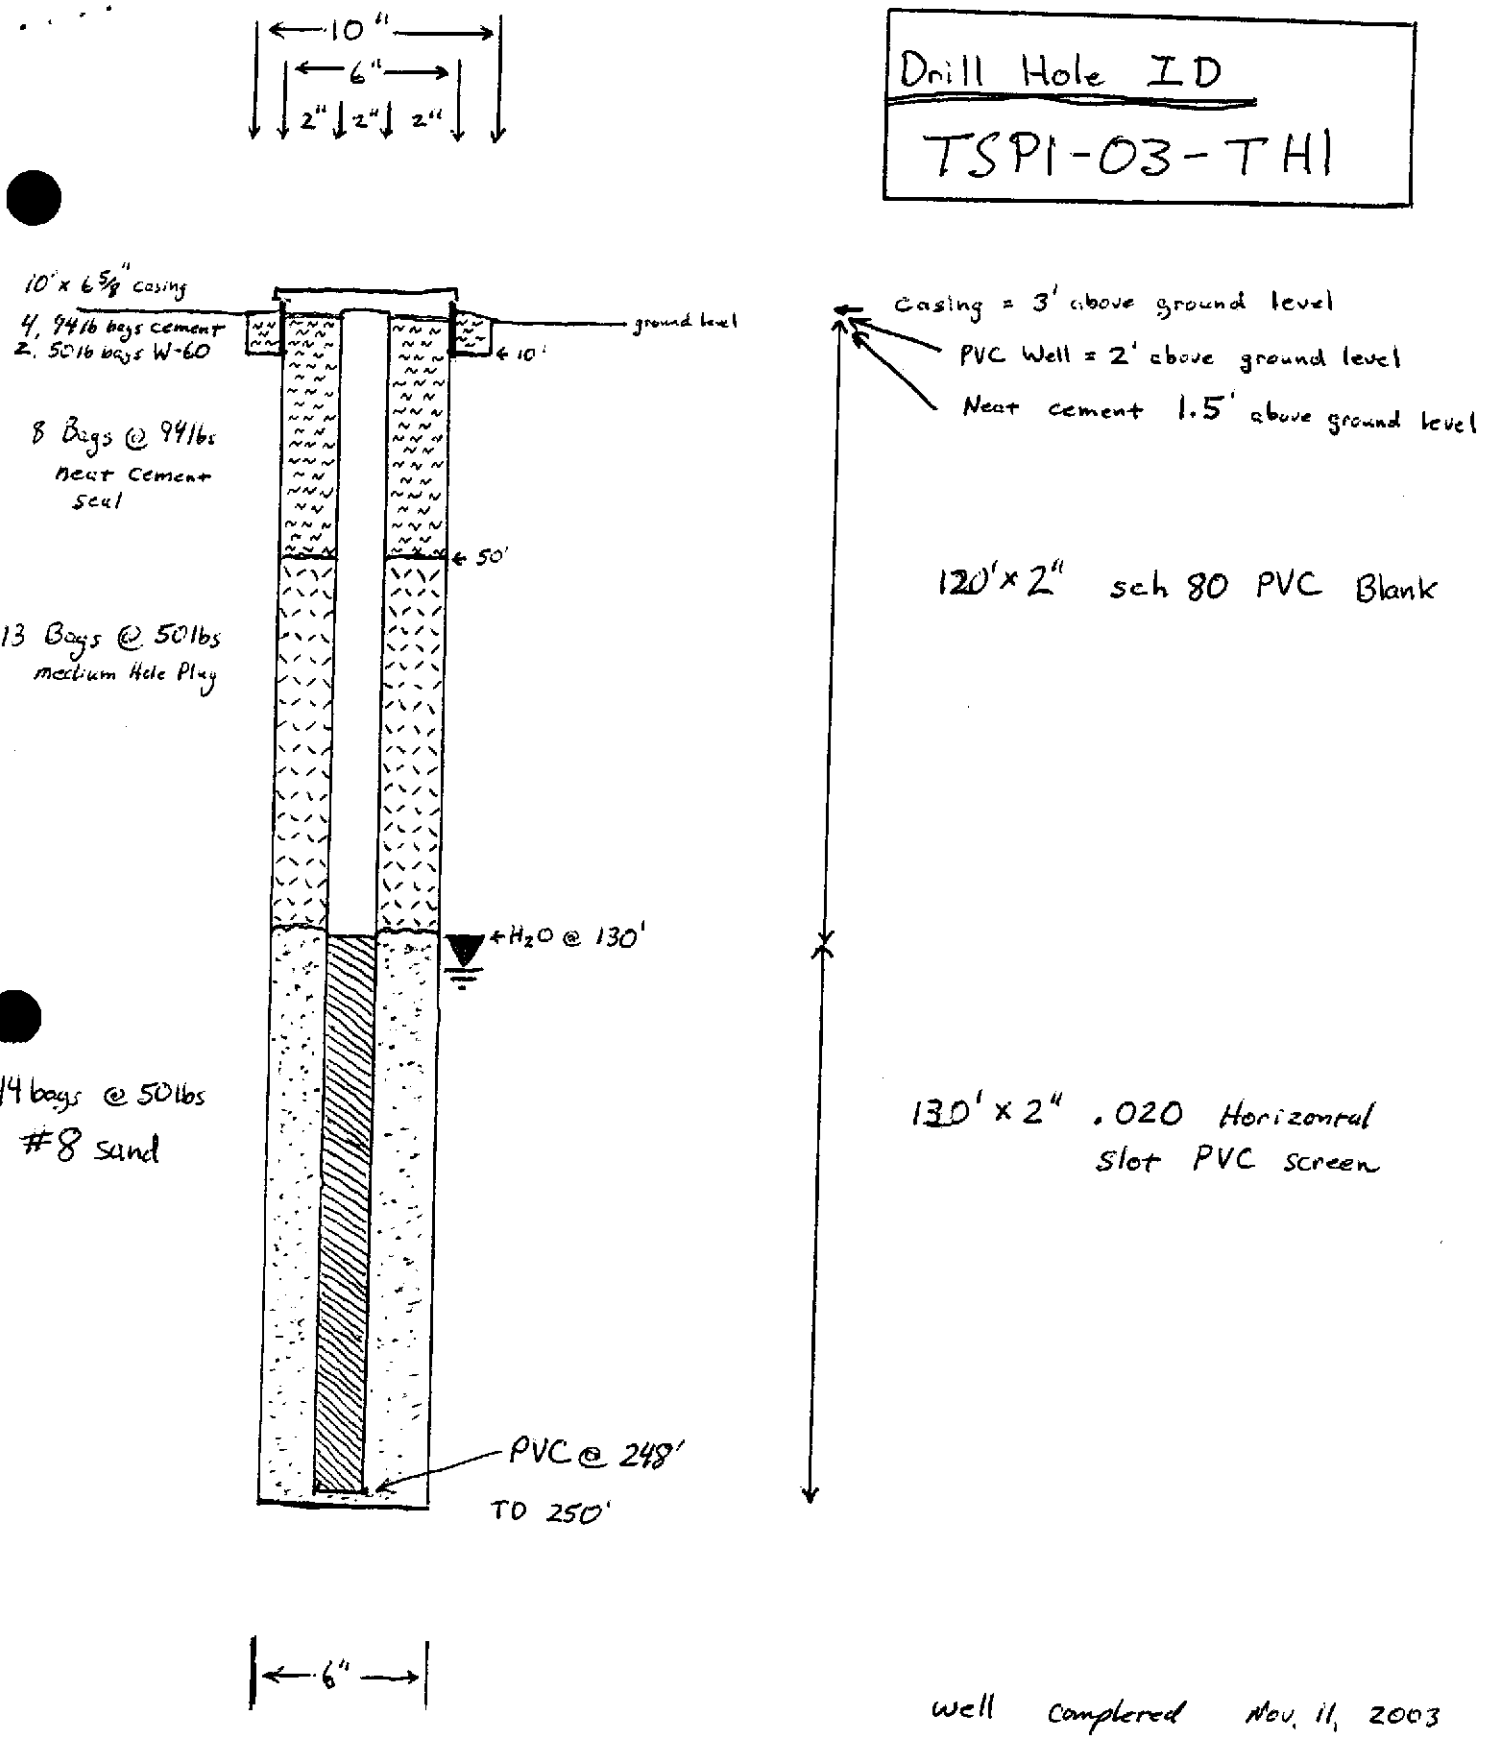

well completed Nov. 11, 2003

by RK Stoeberl

Vertical Scale 1" = 40'

Horizontal - not to scale