Log# 105014

SW¼ SW¼ Sec. 29 24N 58E Permit 64061

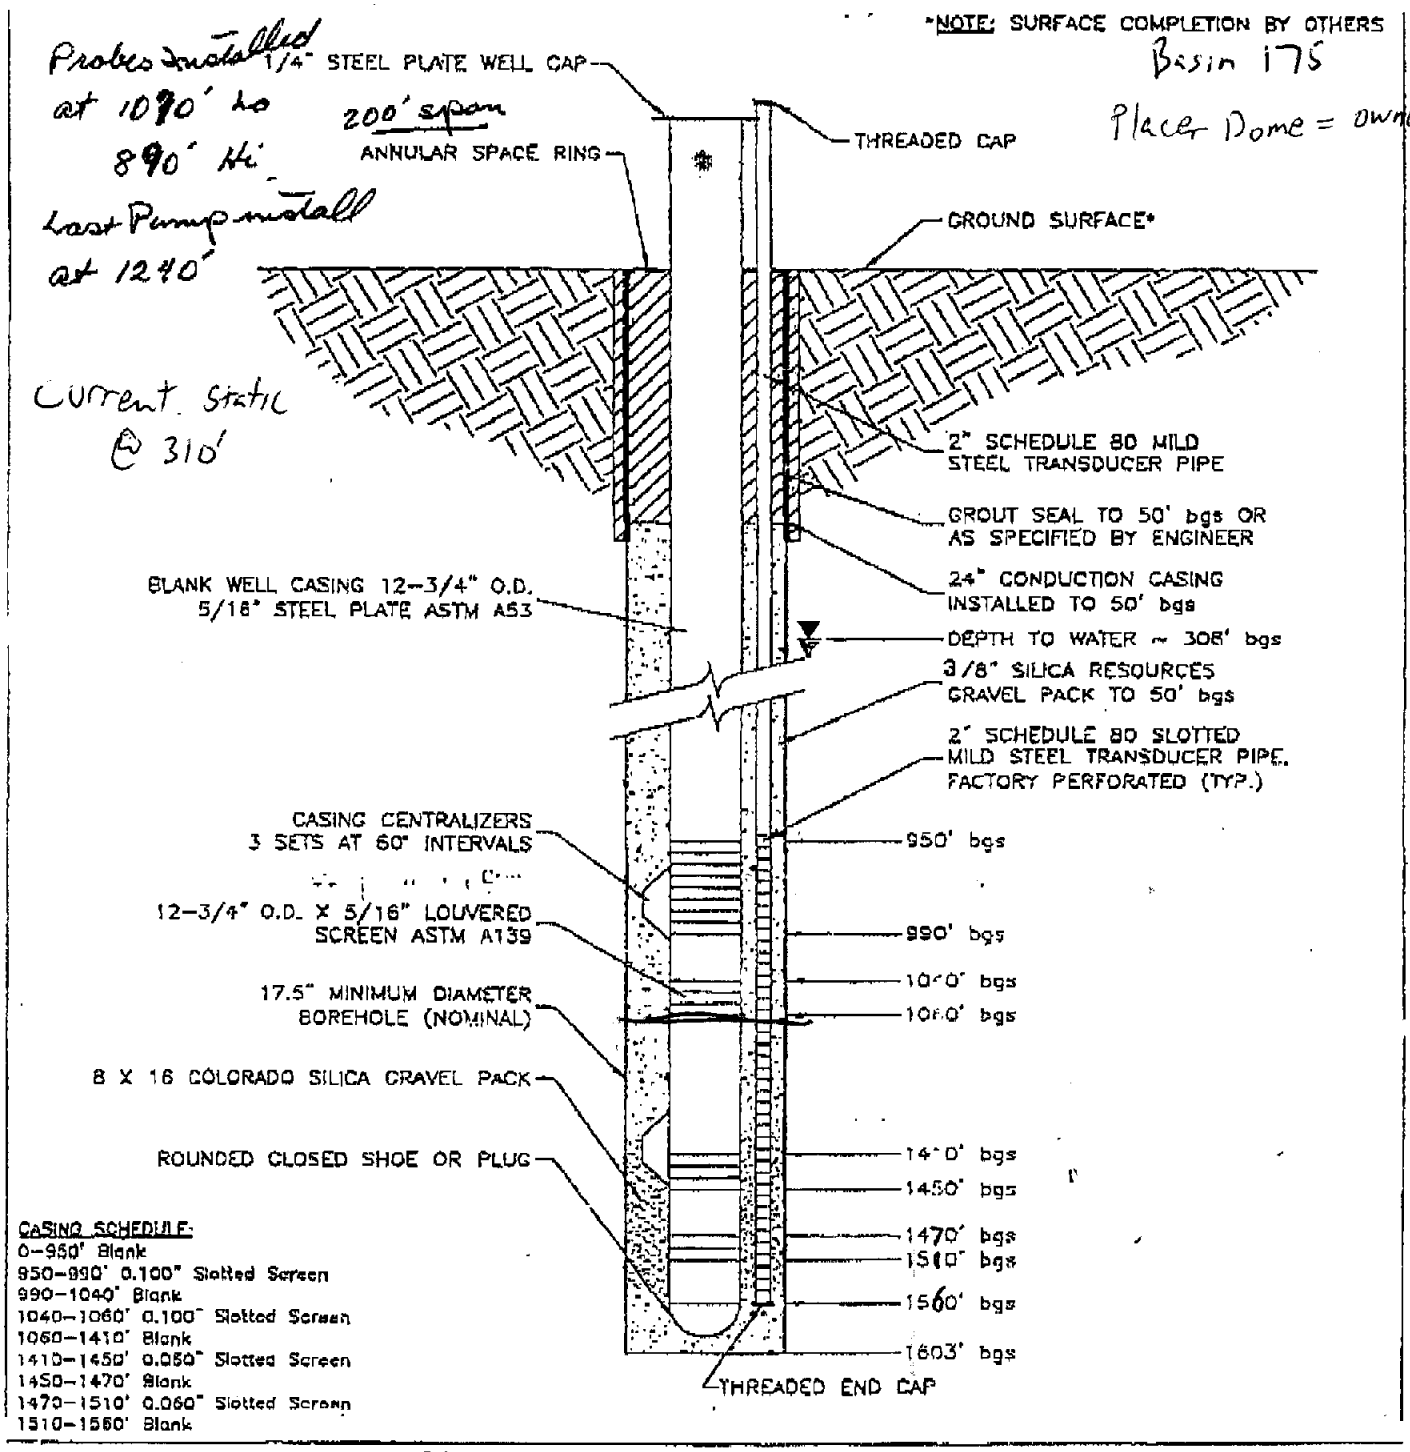

ASBUILT WELL CONSTRUCTION DIAGRAM

MOONEY BASIN PROJECT
72 Miles NW of Ely
Ely, Nevada

Scale	N.T.S.
Date	9/16/98
Drafted By	GLE
Checked By	MES
Approved By	MES
File No.	11001G03
Project No.	98-73110-01
Drawing No.	3

CONVERSE CONSULTANTS

Over 50 Years of Dedication in Engineering and Environmental Sciences