STATE OF NEVADA
DIVISION OF WATER RESOURCES
WELL DRILLER'S REPORT

OFFICE USE ONLY
Log No. 119516
Permit No.
Basin 108
BW-59D

PRINT OR TYPE ONLY
DO NOT WRITE ON BACK

Please complete this form in its entirety in accordance with NRS 534.170 and NAC 534.340

NOTICE OF INTENT NO. 69339

1. OWNER Atlantic Richfield Company
MAILING ADDRESS 4 Centerpoint Drive
LA palma CA 90623

ADDRESS AT WELL LOCATION Verington Mine site and Surrounding Areas
Subdivision Name: County: Lyon

2. LOCATION SW ¼ SE ¼ Sec 27 T 14 N/S R 25 E
PERMIT/WAIVER No. 9-2007-0005
issued by Water Resources
Parcel No. 014-241-37

Latitude 39.041430°N
Longitude 119.170441°W
UTM E ~~353135.64~~ ☒ NAD 27
N ~~1562826.22~~ ☐ NAD 83/WGS 84

3. WORKED PERFORMED
☒ New Well ☐ Replace ☐ Recondition
☐ Deepen ☐ Other

4. PROPOSED USE
☐ Domestic ☐ Irrigation ☐ Test
☐ Municipal/Industrial ☒ Monitor ☐ Stock

5. WELL TYPE
☐ Cable ☐ Rotary ☐ RVC
☐ Air ☒ Other Sonic

6. LITHOLOGIC LOG

Material	Water Strata	From	To	Thickness
Nad 27				
39.041430°N				
119.170441°W				

RECEIVED 2014 JAN 14 AM 11:39 STATE ENGINEERS OFFICE

Date started: 1-6- , 20 14
Date completed: 1 10 , 20 14

7. Water Level
Static water level: feet below land surface
Artesian Flow: G.P.M. P.S.I.
Water Temperature: °F
Quality:

8. WELL TEST DATA
TEST METHOD: ☐ Bailer ☐ Pump ☐ Air Lift

G.P.M.	Draw Down (Feet Below Static)	Time (Hours)

9. WELL CONSTRUCTION
Depth Drilled 340' Feet Depth Cased 247' Feet

HOLE DIAMETER (BIT SIZE)

		From		To	
7"	Inches	0'	Feet	340'	Feet
	Inches		Feet		Feet
	Inches		Feet		Feet

CASING SCHEDULE

Size O.D. (Inches)	Weight/Ft. (Pounds)	Wall Thickness (Inches)	From (Feet)	To (Feet)
2"	Sch 40	PVC	0	247'

Perforations:
Type of perforation factory cut
Size of perforation 0.20
From 227' feet to 247' feet
From feet to feet
From feet to feet
From feet to feet
From feet to feet

Annular Seal: ☒ Yes ☐ No
☐ Neat Cement to ☐ Pumped ☐ Poured
☒ Cement Grout 0 to 222 ☒ Pumped ☐ Poured
☐ Concrete Grout to ☐ Pumped ☐ Poured
☐ ≥30% Bentonite Grout to ☐ Pumped ☐ Poured

Gravel Pack: ☒ Yes ☐ No 225 to 249' ☐ Pumped ☐ Poured
Type: #3
Bentonite Chips: ☒ Yes ☐ No 222 to 225 ☐ Pumped ☒ Poured
Type: MEDIUM 3/8

10. DRILLER'S CERTIFICATION
This well was drilled under my supervision and the report is true to the best of my knowledge.
Name Cascade Drilling LP.
Contractor
Address 1333 W 9th Street
Contractor
Upland, CA 91786
Nevada contractor's license number issued by the State Contractor's Board 73966
Nevada driller's license number issued by the Division of Water Resources, the on-site driller 2475 CPD
Signed [signature]
By driller performing actual drilling on-site or contractor
Date

(Rev. 05-06)

USE ADDITIONAL SHEETS IF NECESSARY

(NSPO 3-08) (O) 627

log 119816

BROWN AND CALDWELL

Date Checked	Checked By	Job Number	By	Date	Calc. No.	Sheet No.
		144230	JR	10/23/13		1
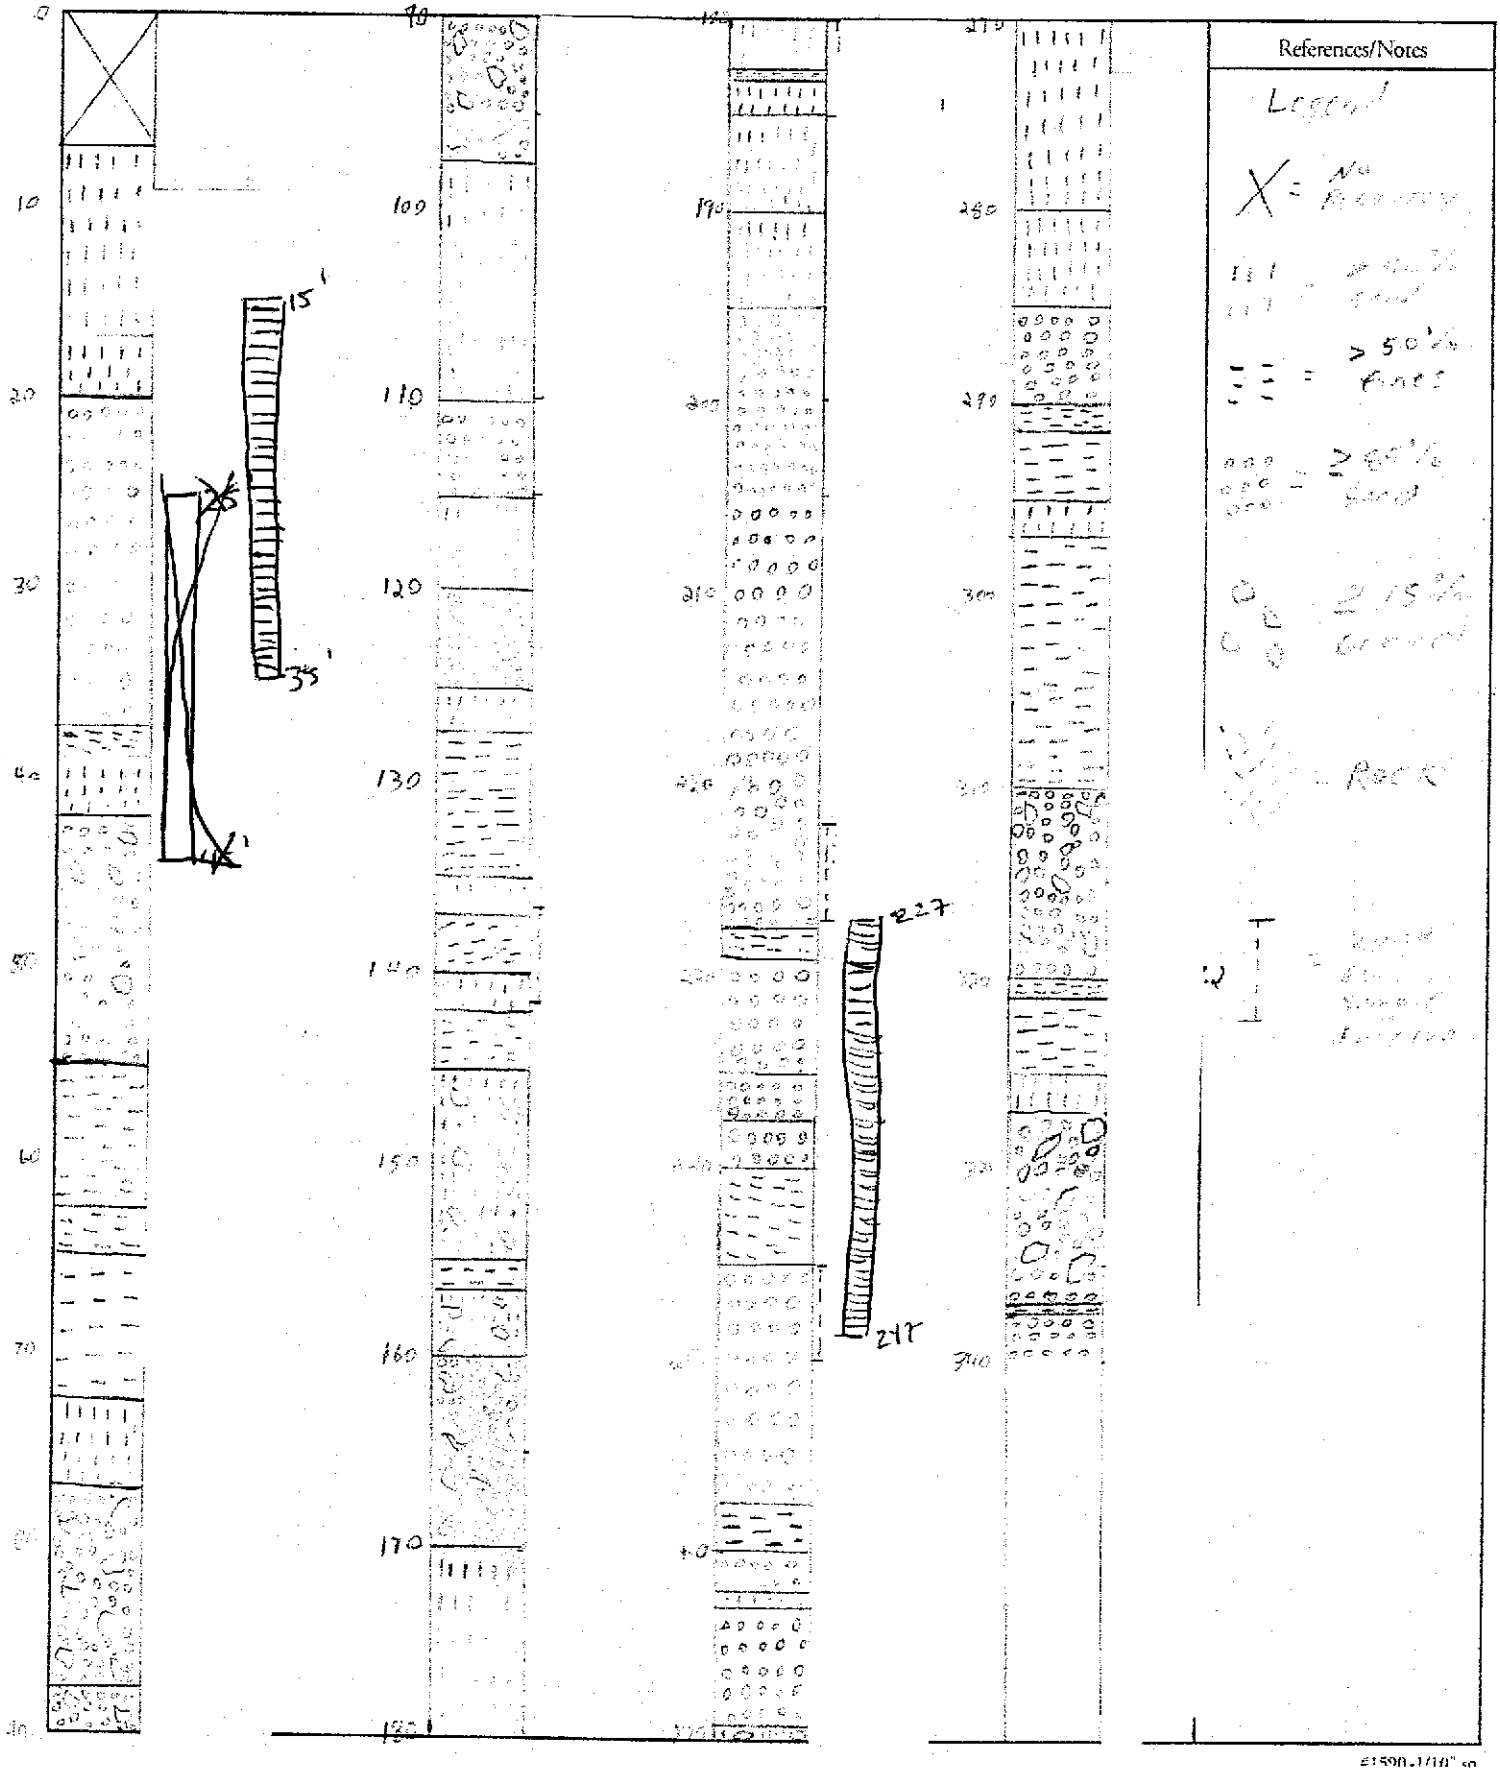
Project	Subject
Yerington Additional Well Installation	B/W-59 Lithology Log